


Section 35 Township 14 Range 14-W

Well No. #1 Herbel

Company Braden & McClure

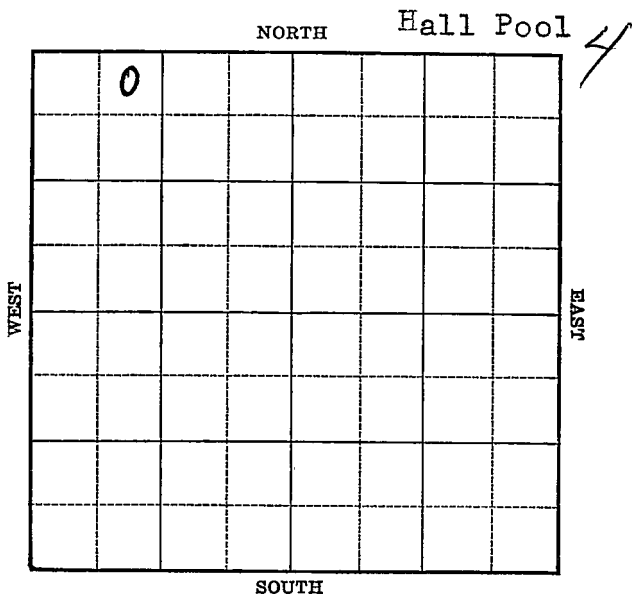

KANSAS

Russell

Sec. 35 Twp. 14 R. 14-W

Well No. #1 Herbel Farm

Braden &amp; McClure

Company

(Hall)


330 Ft. from N. Line

Ft. from S. Line

Ft. from E. Line

990 Ft. from W. Line

Elev. 1775

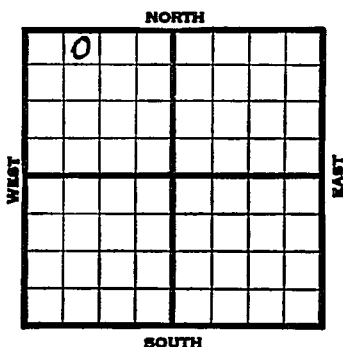

| 1939  | REPORT                      |
|-------|-----------------------------|
| 10/11 | Rigging up cable.           |
| 10/19 | 12" - 425' WOC.             |
| 10/26 | Anhy 758' 10" - 758'        |
|       | Drlg. 1635'                 |
| 11/2  | 8" - 2373' Drlg. 2610'      |
| 11/9  | 7" - 2933' S.O. 3023-26'    |
|       | 1" bail per hour 3035-40'   |
|       | Drlg. 3085'                 |
| 11/16 | Lans. 2931' T.D. 3085'      |
|       | 2900' oil.                  |
| 11/22 | Granite Wash 3173'          |
|       | 5" - 3180'                  |
|       | T.D. 3185'                  |
|       | Potential 2221 bbls., pump. |
|       | COMPLETED                   |

Russell KANSAS

Map No. 72 Sec. 35 Twp. 14 R. 14WWell No. 1 HerbelBraden & McGlure

Company

Contractor

## FIRST REPORT

NE NW NW

330 Ft. from N. Line       Ft. from S. Line       Ft. from E. Line990 Ft. from W. Line

HALL POOL

## SECTION PLAT

|  |  |  |  |
|--|--|--|--|
|  |  |  |  |
|  |  |  |  |
|  |  |  |  |
|  |  |  |  |

Location                                 Rig up                                 

Drilling and Remarks:

Rigging Up Cable

## RECORD

Cased            in.,            ft.Sand                                 Gas                                 Oil                                 Total Depth                                 

## PRODUCTION

1st 24 hrs. Nat.                                 1st 24 hrs. after shot                                 Gas                                  Cu. Ft.Dry Hole                                 Abandoned                                 

Date

OCT 11 1939

19

S. J. LEWIS

Scout

Map No. 72 Sec. 35 Twp. 14 R. 14WWell No. 1 HerbelBraden & McClure

Company

Contractor

COMPLETED

## SECTION PLAT

|  |  |  |  |
|--|--|--|--|
|  |  |  |  |
|  |  |  |  |
|  |  |  |  |
|  |  |  |  |

330 NE NW NW  
Ft. from N. Line

Ft. from S. Line

Ft. from E. Line

990 Ft. from W. Line

HALL POOL

Location

Rig up

Drilling and Remarks:

*Granite Quar 43173**5" @ 3180**Pump 2221 P.X.*

## RECORD

Cased \_\_\_\_\_ in., \_\_\_\_\_ ft.

Sand \_\_\_\_\_

Gas \_\_\_\_\_

Oil \_\_\_\_\_

Total Depth 3185

## PRODUCTION

1st 24-hrs. Nat. \_\_\_\_\_

1st 24 hrs. after shot. \_\_\_\_\_

Gas \_\_\_\_\_ Cu. Ft.

Dry Hole \_\_\_\_\_

Abandoned \_\_\_\_\_

Date

NOV 22 1939 19

S. J. LEWIS Scout