


Section.....35.....Township.....14.....Range.....**KANSAS**.....14W

Well Number.....1.....Strecker.....


Company.....Empire.....

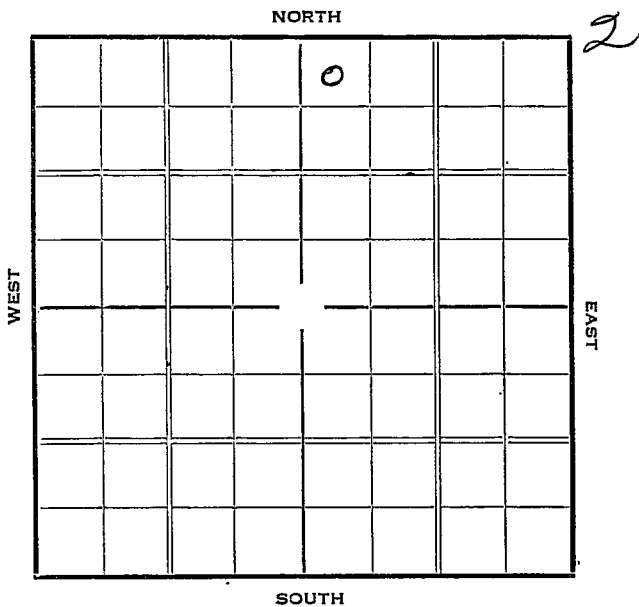

Map No. _____ Sec. 35 Twp. 14 R. 14-W

Well No. #1 Strecker Farm _____
Empire Company _____

NORTH

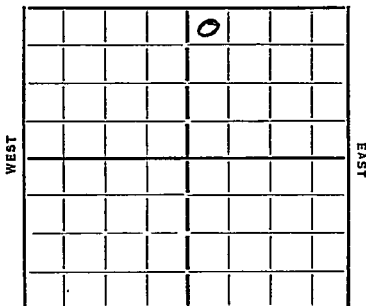

330 Ft. from N. Line

_____ Ft. from S. Line

_____ Ft. from E. Line

330 Ft. from W. Line

Elev. 1778

SOUTH

Date	REPORT
1936	
12/2	R O G
12/10	Rigging up.
12/17	" "
12/24	20" @ 22'. 15" @ 445'. Drlg. 920'.
12/29	Show gas 1585'. Drlg. 1740'.
1937	
1/7	2118' underream 10".
1/14	10" @ 2155'. Show oil 2330-35 Drlg. 2545'.
1/21	8" @ 2934'. Clean out.
1/28	Granite wash 3190'. Pay 3190-92'. T. D. 2800' oil 4 hrs.
2/3	Granite Wash 3190'. Pay 3190-92'. T. D. 3192'. Potential 1123'.
	COMPLETED

Map No. 72 Sec. 35 Twp. 14 R. 14WWell No. 1 SteckerEmpire Company

Contractor

SECTION PLAT

		0	

330 Ft. from N. Line

_____ Ft. from S. Line

_____ Ft. from E. Line

330 Ft. from W. Line

FIRST REPORT

Location _____

Rig up _____

Drilling and Remarks:

ROG

RECORD

Cased _____ in., _____ ft.

Sand _____

Gas _____

Oil _____

Total Depth _____

PRODUCTION

1st 24 hrs. Nat. _____

1st 24 hrs. after-shot _____

Gas _____ Cu. Ft.

Dry Hole _____

Abandoned _____

Date

DEC. 2 1936 19

S. J. LEWIS Scout

Russell
 Map No. 72 Sec. 35 Twp. 14 R. 14W

Well No. 1 Stecker

Empire Company

Contractor

SECTION PLAT

		0	

330 Ft. from N. Line

_____ Ft. from S. Line

_____ Ft. from E. Line

330 Ft. from W. Line

COMPLETED

Location _____

Rig up _____

Drilling and Remarks:

Granite Wash
 3190

Pay 3190-92.

Potential
 1123

RECORD

Cased _____ in., _____ ft.

Sand _____

Gas _____

Oil _____

Total Depth 3192

PRODUCTION

1st 24 hrs. Nat. _____

1st 24 hrs. after shot _____

Gas _____ Cu. Ft.

Dry Hole _____

Abandoned _____

Date

FEB 3 1937 19

E. J. LEWIS

Scout