

Form 51-5M-11-38-Palace

Russell

Section 35 Township 14 Range 14-W

Well No. ~~#4~~ Herbel #5

Company A. Billings

NORTH Gurney Pool

3


KANSAS


Russell

Sec. 35 Twp. 14 R. 14-WWell No. #4 Herbel #5 FarmA. Billings Company

(Gurney)

330 Ft. from N. Line Ft. from S. Line990 Ft. from E. Line Ft. from W. Line

Elev. 1766

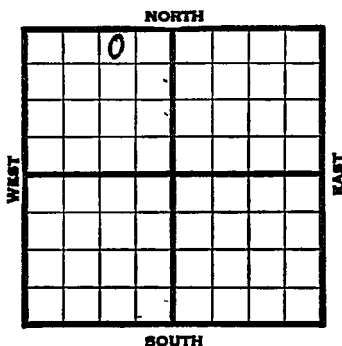

1939	REPORT
11/28	Location
12/7	Skidding in cable rig from #1.
12/14	Rigging up.
12/21	" "
12/28	" "
1940	
1/4	" "
1/11	" "
1/18	" "
1/25	" "
2/1	Shut down.
2/8	" "
2/15	" "
2/23	" "
2/29	" "
3/8	" "
3/14	SD 765'
3/21	Anh. 745' 13" - 418'
	10" - 765' Drlg. 1615'
3/28	8" - 2350' Drlg. 2440'
	OVER

1940

4/4 Topeka 2628' Lans. 2925'

7" - 2925' Drlg. 3140'

4/12 Gorham 3171' Pay 3171-74' T.D.
H.F.O. - 6 hours. 5" - 3171'
WOC.

4/17 Gorham sand 3171'

5" - 3171'

T.D. 3177'

Pump 2254 bbls., potential.

COMPLETED

Map No. 72 Sec. 35 Twp. 14 R. 14WWell No. 4 Herbel

A. Billings

Company

Contractor

FIRST REPORT

NW NE NW

330 Ft. from N. Line

Ft. from S. Line

290 Ft. from E. Line

Ft. from W. Line

SECTION PLAT

	o		

GURNEY POOL

Location X

Rig up

Drilling and Remarks:

RECORD

Cased _____ in., _____ ft.

Sand _____

Gas _____

Oil _____

Total Depth _____

PRODUCTION

1st 24 hrs. Nat. _____

1st 24 hrs. after shot _____

Gas _____ Cu. Ft.

Dry Hole _____

Abandoned _____

Date

NOV 28 1939

19

S. J. LEWIS Scout

Misc Small Maps

Cards

Tracing

France Map

Scarborough Map

Moody Map

Geological Dept.

Moody Flat Book



26—200 Bks.—1-40—Palace

Russell KANSAS

Map No. 72 Sec. 35 Twp. 14 R. 14WWell No. 5 HerbelA. Billings Company

Contractor

COMPLETED

NW NE NW

330 Ft. from N. Line Ft. from S. Line990 Ft. from E. Line Ft. from W. Line

GURNEY POOL

SECTION PLAT

	0		

Location Rig up

Drilling and Remarks:

*Good kam Sol**2171**5" @ 3171**Pump 225 H.P.*

RECORD

Cased in., ft.Sand Gas Oil Total Depth 3177

PRODUCTION

1st 24 hrs. Nat. 1st 24 hrs. after shot Gas Cu. Ft.Dry Hole Abandoned

Date

APR 17 1940 19S. J. LEWIS Scout



Misc Small Maps	RAM
Cards	Handwritten signature
Tracing	Handwritten signature
France Map	Handwritten signature
Scarborough Map	
Moody Map	✓
Geological Dept.	
Moody Flat Book	

Map No. _____ Sec. 35 Twp. 14 R. 14WWell No. 5 HerbelA. Billings

Company

CORRECTION

Contractor

NW NE NW

330 Ft. from N. Line

_____ Ft. from S. Line

990 Ft. from E. Line

_____ Ft. from W. Line

SECTION PLAT

	o		

GURNEY POOL

Location _____

Rig up _____

Drilling and Remarks:

Reported as #4

RECORD

Cased _____ in., _____ ft.

Sand _____

Gas _____

Oil _____

Total Depth _____

PRODUCTION

1st 24 hrs. Nat. _____

1st 24 hrs. after shot _____

Gas _____ Cu. Ft.

Dry Hole _____

Abandoned _____

Date

APR 17 1940 19

S. J. LEWIS Scout

~~Cheek well number.~~

~~We show this well as #4.~~

~~Paul.~~

Misc Small Maps	<i>Paul</i>
Cards	<i>Paul</i>
Tracing	<i>Joe</i>
France Map	<i>Paul</i>
Scarborough Map	<i>Paul</i>
Moody Map	
Geological Dept.	
Moody Plat Book	