


Section 35 Township 14 Range 14W

Well No. #1 Strecker

Company Earl Wakefield

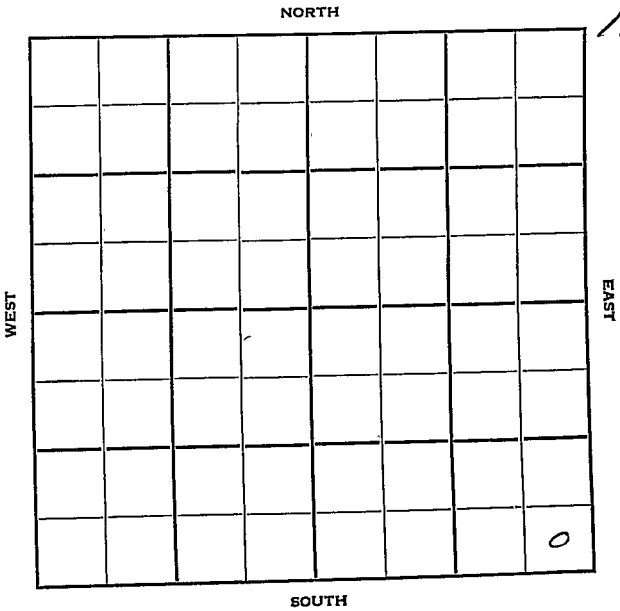

Russell

KANSAS

Sec. 35 Twp. 14 R. 14W ✓

Well No. #1 Strecker Farm

Earl Wakefield Company

Hall-Gurney Contractor

Ft. from N. Line

330'


Ft. from S. Line

330'

Ft. from E. Line

Ft. from W. Line

SE SE SE

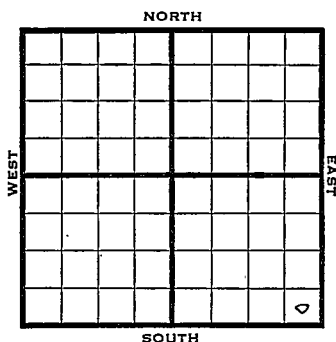

1950

Elev 1744'

REPORT

2/8

Drlg. 65'

4/5

TD 3218'

15"@ 65'

12"@ 386'

10"@ 736'

8"@ 2460'

Lans 2968'

Cong 3158'

D&A

Aband.


ABANDONED

Hall-Gurney

(ans 23)

Map No. _____ Sec. 35 Twp. 14 R. 14WWell No. 1 Strecker_____Earl Wakefield_____
Company_____SE SE SE_____
Contractor

SECTION PLAT

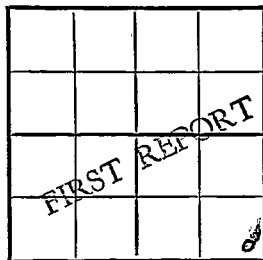_____Ft. from N. Line330 Ft. from S. Line330 Ft. from E. Line_____Ft. from W. LineRussell County

Location _____

Rig up _____

Drilling and Remarks:

drlg. 65

RECORD

Cased _____ in., _____ ft.

Sand _____

Gas _____

Oil _____

Total Depth _____

PRODUCTION

1st 24 hrs. Nat. _____

1st 24 hrs. after shot _____

Gas _____ Cu. Ft.

Dry Hole _____

Abandoned _____

Date

FEB 8 195019J. E. TYRA
Scout

Kansas

Hall-Gurney

Map No. _____ Sec. 35 Twp. 14 R. 14WWell No. 1 StreckerEarl Wakefield

Company

Contractor


SE SE SE

E/ 1744
SECTION PLAT

_____ Ft. from N. Line

330 Ft. from S. Line330 Ft. from E. Line

_____ Ft. from W. Line

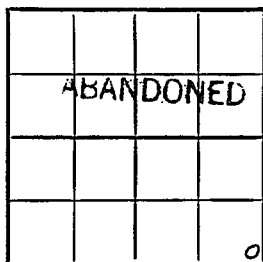

Russell County

Location _____

Rig up _____

Drilling and Remarks:

15" @ 65
 12" @ 386
 10" @ 736
 8" @ 2460
 Loss 2968
 Cong 3158

RECORD

Cased _____ in., _____ ft.

Sand _____

Gas _____

Oil _____

Total Depth 3218

PRODUCTION


Dry Hole _____

Abandoned _____

Date

APR 5 1950

19

J. E. TYRA

Scout