

Ellis


KANSAS

SECTION 36 TOWNSHIP 14 RANGE 16W

WELL NO. #1 Wagoner

COMPANY L. B. Stableford

NORTH

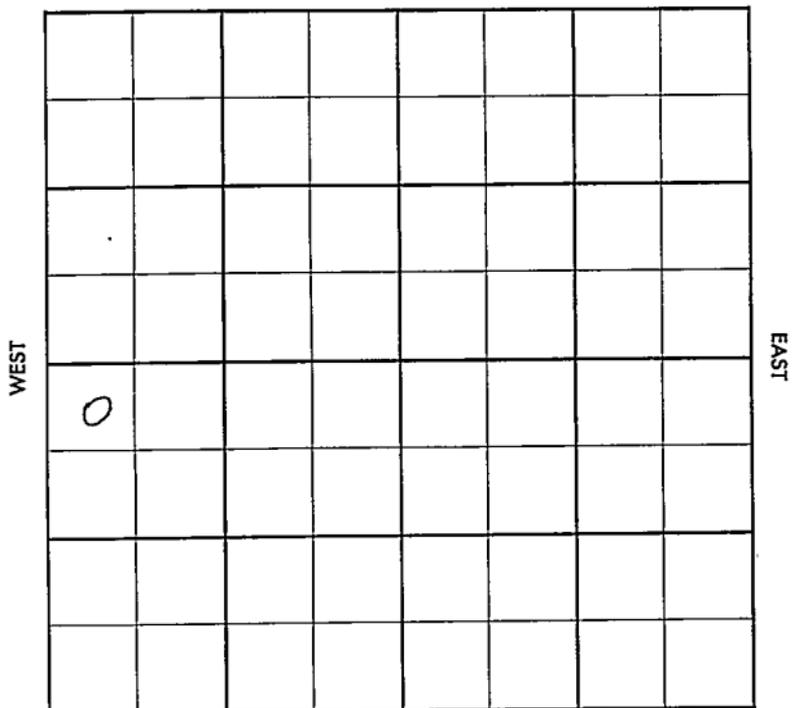

SOUTH

WEST

EAST



County Ellis Elev. 1892  
 Sec. 36 Twp. 14 Rge. 16W  
 Company L. B. Stableford  
 Farm Name Wagoner No. 1

TOPS	DEPTH	LOG	DATUM
Anb.	900		
Tp.			
H.	3097		
Tr.			
Dg.			
Bl.			
L.			
K.C.	3152		
B.K.C.			
Ce.			
C.			
M.			
M.			
K.			
Mz.			
Me.			
V.			
S.			
S.	3391		
A.			
R.			
Pe.			
G.			
T.D.			

Loc. in Sec. NW NW SW  
 Geol. \_\_\_\_\_  
 Contr. Peel Bros.  
 Pool Wildcat

FIRST REPORT  
 APR 18 '66

Date Comm. DST 3156-67 open 1 hr. rec. 40' gm  
460# DST 3390-3400 open 1 hr. rec.  
25' mud 0# DST 3400-30 open 1 hr.  
rec. 50' hoem 450' gassy oil 725#  
TD 3430 5" @ 3429

*(Faint handwritten notes and a large handwritten 'X' mark are present at the bottom of the page.)*

County BITTIS Elev. 1892  
 Sec. 36 Twp. 11 Rge. 16W  
 Company L. B. Stableford  
 Farm Name Wagoner No. 1

TOPS	DEPTH	LOG	DATUM	Loc. in Sec.
Anh.	250			NW NW SW
TP.				
H.	3007			
Tr.				
Dg.				
Bl.				
L.				
K.C.	3152			Geol.
B.K.C.				Contr.
Ce.				Pool
C.				Wagoner
M.				Pool
M.				Wagoner
K.				Pool
Mz.				Wagoner
Mo.				
V.				
S.				
S.				
A.	3311			COMPLETE
R.				
PE.				
G.				
TD.	3430			

Date Comm. JUN 6 1956

DOT 3152-67 open 1 cr. rec. 101 con

150' DOT 3310-34 open 1 cr. rec.

251' DOT 3402-34 open 1 cr.

rec. 50' corr 150' test oil 725'

(21330) 5" 3129 APR 25 '56 V Co 3430

#/3412-16 test 550 28/3420-27

55 gal acid & 3 1/3 Boreh no/w

POP MAY 2 '56 MAY 9 '56 P. 72 B30 no/w

78 hrs MAY 15 '56 MAY 23 '56 P. 42 Boreh

36-14-16<sup>w</sup>

FORM 513-1 SUNRAY

Stableford Wagner # 8

MAY 29 '56 JUN 6 '56

1PP

88

BOPD

+27<sup>w</sup>

33°

Arb

No Total Depth shown. Please advise.

Thanks.

Sam Baird

6-22-56

RG