


Section 36 Township 14 Range 30 W

Well No. # 1 Lundren "A"

Company Mid-States & Wycoff-Williams

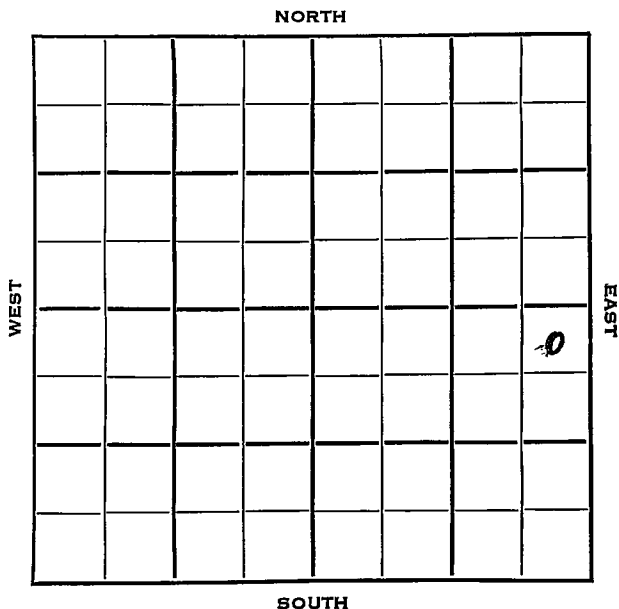

Sec. 36 Twp. 14 R. 30W

Well No. #1 Lundren "A" Farm

Mid-States & Wycoff-Williams Company

Wycoff-Williams Contractor


330 Ft. from N. Line

Ft. from S. Line

330 Ft. from E. Line

Ft. from W. Line

NE NE SE

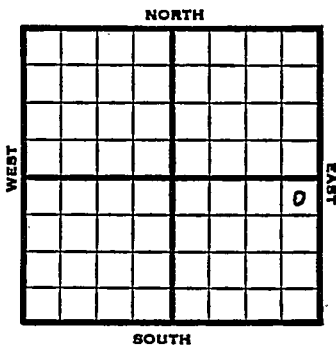

1952 Elev. 2675' REPORT

- 12/3 Location
- 12/4 " "
- 12/11 " "
- 12/18 Location
- 12/25 " "
- 1/1 C&P
- 1/8 8" @ 129
- 1/22 Heeb 3680' KC 3717'  
DST 3972-4003, 1 hr, 300' M, 90' SW  
750# Miss 4300'  
DST 4300-4350'
- 1/29 (Cor. Miss 4332  
DST 4545-62, 2 hrs., 115' hly  
OCSW 1030#)  
DST 4290-4322, failed,  
RTD 4371  
5" @ 4370
- 2/5 GO 4363 /4354-60 S/1/2 BFPH 50% oil  
500 A S/10 BO plus 15 BW 8 hrs.
- 2/12 NR
- 2/19 P/70 BO plus 10 BW 16 hrs.  
P/23 BO plus 26 BW 24 hrs.
- 2/26 NR
- 3/12 NR

OVER

1953  
3/19 NR  
3/26 NR  
4/2 NR  
4/9 P/ 5 BO / 45 bwpd  
4/16 NR  
4/23 "  
4/29 Dupud 1-5-53  
Oil Well  
TD 4371  
8" @ 129  
Heeb 3680, KC 3717  
DST 3972-4003, opn 1 hr., rec. 300' mud  
90' sw, 750#, Miss 4332  
DST 4345-62, opn 2 hrs., rec. 115'  
hocsw, 1030#  
DST 4290-4322, failed  
TD 4371  
5" @ 4370  
CO to 4363  
perf/4354-60,  
S/1/2 bfph, 50% oil, 500A  
S/10 bo 15 bw 8 hrs.  
P/70 bo 10 bw 16 hrs.  
Pump 23 bopd 26 bw 2000A  
P/8 bfph 90% wtr.  
P/ 10 bopd 86 bw  
P/ 9 bo 36 bw  
P/15 bo 135 bwpd  
P/5 bo 45 bwpd  
Comp. 10 bopd 7 bw

**COMPLETED**



DEC 5 1952

Scout Cards	_____
Land Small Map	_____
Land Wall Map	_____
Tracings	_____
France Map	_____
Pierce Map	_____
Misc.	_____



MAY 6 1953

Scott Cards	<i>ad</i>
Land Small Map	
Land Wall Map	<i>32</i>
Tracings	
France Map	
Pierce Map	
Misc.	