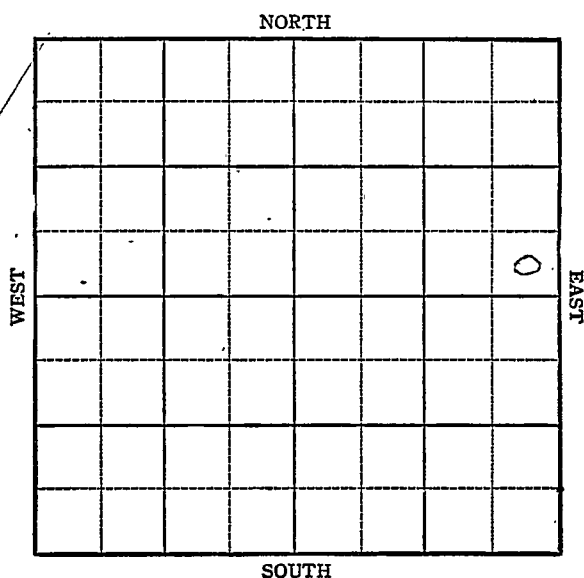


Section 36 Township 14 Range 15WWell No. #1 DanglerCompany M. R. Armer

KANSAS

Russell County

Sec. 36 Twp. 14 R. 15W

Well No. #1 Dumler Farm

M. R. Armer Company


Big Creek

 Ft. from N. Line

330 Ft. from S. Line

330 Ft. from E. Line

 Ft. from W. Line

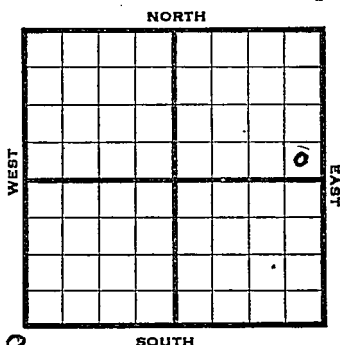

SE NE *Elev. 1728*

1944

R E P O R T

9/20 8" @ 212
Anhy 755
Drlg. 1788'

9/28 Drlg. 2805

10/4 Lans 2929
Arh 3155-59 TD
TD 3159
5" @ 3155 RUST

10/11 " " " "

10/18 " " "

10/25 500 acid
SD & Wtr PB 3050
21 shots 2935-45 4000 acid
swb 20 oil a day

11/1 Arb 3155
5" @ 3155
TD 3159
4500 acid

ABANDONED

KANSAS

Pool Name Big CreekMap No. 72 Sec. 36 Twp. 14 R. 15WWell No. 1 Dumlér

M. R. Armer


Company

FIRST REPORT

Contractor

SE NE

SECTION PLAT

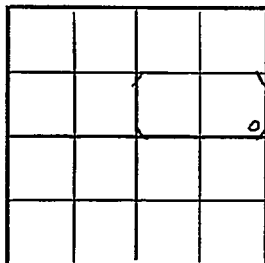

Ft. from N. Line

330 Ft. from S. Line330 Ft. from E. Line

Ft. from W. Line

Russell County

Location

Rig up

Drilling and Remarks:

8" - 212

Anhy 755

1788

RECORD

Cased _____ in., _____ ft.

Sand _____

Gas _____

Oil _____

Total Depth _____

PRODUCTION

1st 24 hrs. Nat. _____

1st 24 hrs. after shot _____

Gas _____ Cu. Ft.

Dry Hole _____

Abandoned _____

Date

SEP 20 1944 19

S. J. LEWIS

Scout

Pool Name Big CreekMap No. 72 Sec. 36 Twp. 14 R. 15WWell No. 1 DanglerM. R. Armer

Company

ABANDONED

Contractor

SE NE

SECTION PLAT

			o

Ft. from N. Line330 Ft. from S. Line330 Ft. from E. LineFt. from W. LineRussell

Location

Rig up

Drilling and Remarks:

Ar 781555-10-31554500 acid

RECORD

Cased in., ft.Sand Gas Oil Total Depth 3159

PRODUCTION

1st 24 hrs. Nat. 1st 24 hrs. after shot Gas Cu. Ft.Dry Hole Abandoned

Date

NOV 1 1944 19S. J. LEWIS

Scout