

KANSAS


Russell

FORM 51 5M BR1X

Section 36 Township 14 Range 15W

Well No. #2, Dumler

Company Milt Reinhardt

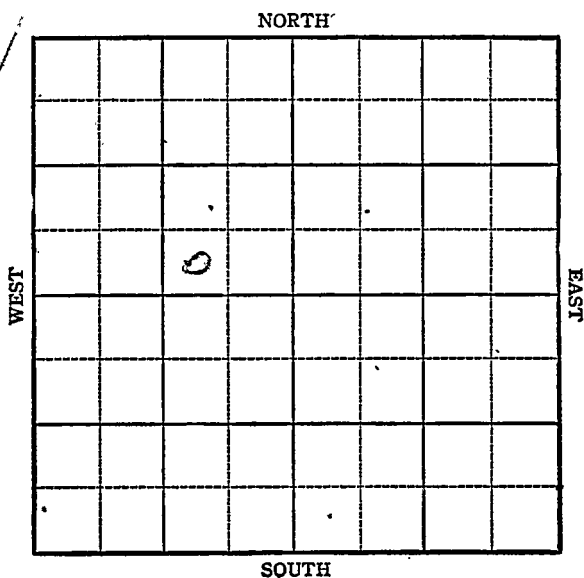


KANSAS

Russell County

Sec. 36 Twp. 14 R. 15WWell No. 2 Dumler FarmMilt Reinhardt Company

Big Creek

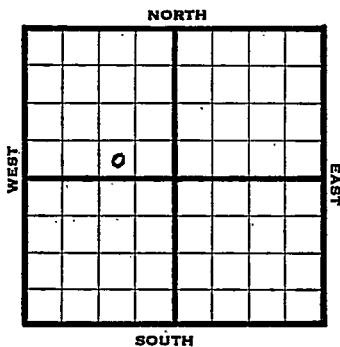 Ft. from N. Line330 Ft. from S. Line990 Ft. from E. Line Ft. from W. LineElev. 1791

1944

REPORT

7/5

Cellar

8/12

"

7/19

Anhy 803

10" A 822

WOC

7/26

Drlg. 840'

8/2

Drlg. 1565

8/9

Drlg. 2175

8/16

Drlg. 25050 8" @ 2365

8/23

Topeka 2710

Lans 2992

2995 NR 7"

8/30

Arb. 3215

TD 3235

HFW

ABANDONED

Pool Name Big Creek

KANSAS
 Map No. 36 Sec. 14 Twp. 15W

Well No. 2 Dumber

Milt Reinhardt Company

FIRST REPORT

Contractor

SW SE NW

SECTION PLAT

	o		

 Ft. from N. Line330 Ft. from S. Line990 Ft. from E. Line Ft. from W. Line

Russell County

Location Rig up

Drilling and Remarks:

Cellar

RECORD

Cased in., ft.Sand Gas Oil Total Depth

PRODUCTION

1st 24 hrs. Nat. 1st 24 hrs. after shot Gas Cu. Ft.Dry Hole Abandoned

Date

JUL 5 1944 19

S. J. LEWIS Scout

Pool Name Big Creek PoolMap No. 72 Sec. 35 Twp. 14 R. 15WWell No. 2 DumlérMilt Reinhardt Company**ABANDONED**

Contractor

SW SE NW

SECTION PLAT

 Ft. from N. Line330 Ft. from S. Line990 Ft. from E. Line Ft. from W. Line

	0		

Russell CountyLocation Rig up

Drilling and Remarks:

See 83215HFW.

RECORD

Cased in., ft.Sand Gas Oil Total Depth 3235

PRODUCTION

1st 24 hrs. Nat. 1st 24 hrs. after shot Gas Cu. Ft.Dry Hole Abandoned

Date

AUG 30 1944 19 S. J. LEWIS Scout