
FORM 51 25M 3-49 PETROL

KANSAS Russell

Section 36 Township 14 Range 15-W

Well No. #2 Dumler

Company W E Wichizer

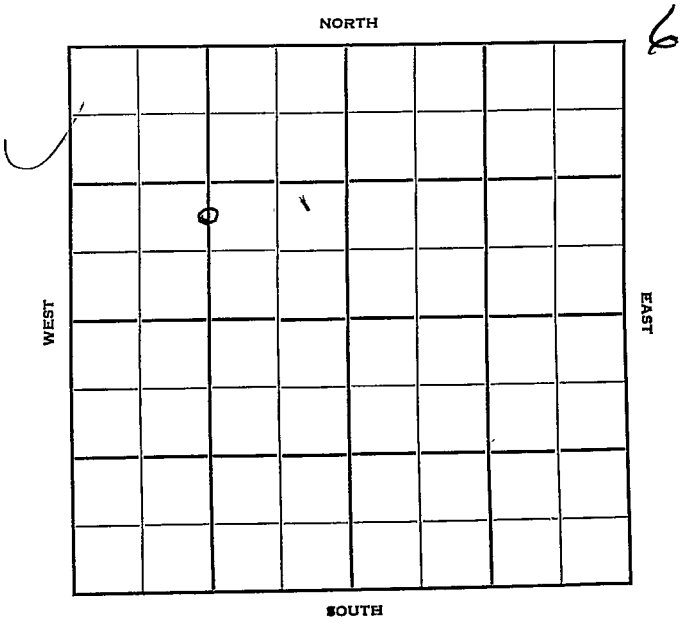

FORM 252-B
10M 9-49 PETROL

KANSAS Russell

Sec. 36 Twp. 14 R. 15-W

Well No. #2 Dumler Farm

W E Wickizer Company

Glen Nye Contractor

Big Creek


Ft. from N. Line

990 Ft. from S. Line

Ft. from E. Line

1320 Ft. from W. Line

C N½ S½ NW

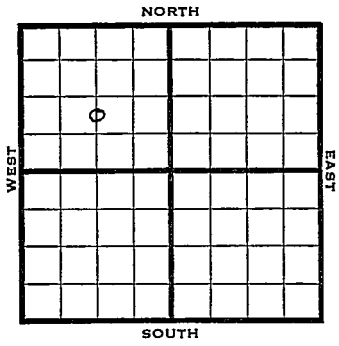

1950	Elev 1791 REPORT
7/12	8" @ 461 Drlg 786
11/15	8" @ 461' Top 2708' Heeb. 2935' Dol. 2955' Lans. 2990' Arb. 3227' 5" @ 3228' TD 3233. SSO 100 A no inc. 500 A S/33 BO 81 BW 18 hr. 11/3229-32 500 A HFW PB 3212 Perf. 6 spots Plug 3050 P/1 GFPH 75% wtr 12 BOPD COMPLETED

Form 26 200 Bks. 11-49 Petrol

Kansas

Big Creek Pool

Map No. _____ Sec. 36 Twp. 14 R. 15W

Well No. 2 Dumler


W. E. Wickizer Company

Glen Nye Contractor

C N½ S½ NW

El. 1791

SECTION PLAT

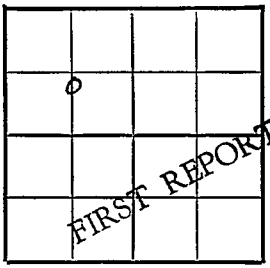

_____ Ft. from N. Line

990 Ft. from S. Line

_____ Ft. from E. Line

1320 Ft. from W. Line

Russell County

Location _____

Rig up _____

Drilling and Remarks:

8" C 461

drlg. 786

RECORD

Cased _____ in., _____ ft.

Sand _____

Gas _____

Oil _____

Total Depth _____

PRODUCTION

1st 24 hrs. Nat. _____

1st 24 hrs. after shot _____

Gas _____ Cu. Ft.

Dry Hole _____

Abandoned _____

Date

JUL 12 1950 19

J. E. TYRA Scout

FORM 275 FOR SALE BY KANSAS BLUE PRINT CO.


County Russell State Kansas

Sec. 36 (Blk. Twp.) 14 (Sur. Rge.) 15W Map No.

Operator W. E. Wickizer

Well No. 2 Farm Dumler

Elev. 1791 Location C N½ S½ NW

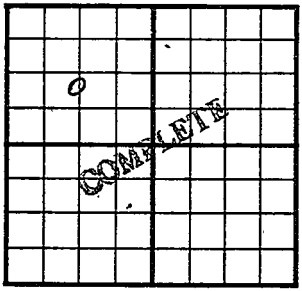

990 Ft. From S Line NW

1320 Ft. From W Line Quarter

1st. Report

Completion NOV 15 1950

Remarks Big Creek Pool

Glen Nye Drlg. - Contr.

Spudding Date

Drlg. Data

8" @ 461 Top. 2708 Heeb. 2935

Dol. 2955 Lans. 2990 Arb. 3227 5" @ 3228

TD 3233 SSO 100 A no inc. 500 A

S/ 33 bo 81 bw 18 hr. 11/ 3229-32

500 A HFW PB 3212 perf. 6 spots

Plug @ 3050 P/ .1 gfph 75% water

OCT 25 ✓ NOV 1 NOV 8 NOV 15

12B0PD.

J. E. TYRA