


Section 36 Township 14 Range 15W

Well Number 1 Dumbler "E"

Company Darby Oil

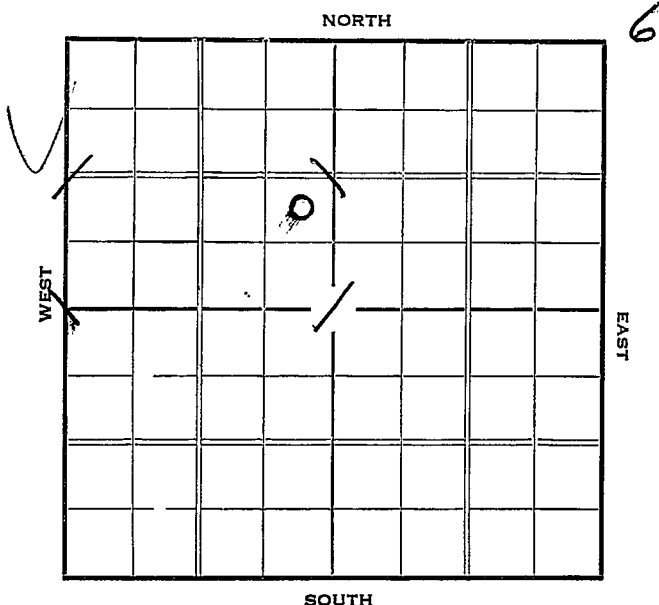

KANSAS *Russell*


Map No. 72 Sec. 36 Twp. 14 R. 15W

Well No. 1 Dumbler "E"

Party Oil Company

Contractor

SECTION PLAT

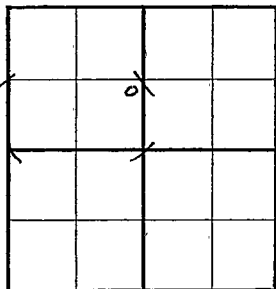

 Ft. from N. Line

990 Ft. from S. Line

330 Ft. from E. Line

 Ft. from W. Line

FIRST REPORT

Location [®]

Rig up

Drilling and Remarks:

Rig

RECORD

Cased in., ft.

Sand

Gas

Oil

Total Depth

PRODUCTION

1st 24 hrs. Nat.

1st 24 hrs. after shot

Gas Cu. Ft.

Dry Hole

Abandoned

Date

MAR 17 1937 ₁₉

S. J. LEWIS

Scout

Russell KANSAS

Map No. 72 Sec. 36 Twp. 14 R. 15^W

Well No. 1 - Dumbler "E"

Darby Company
 Contractor

~~COMPLETED~~

SECTION PLAT

	0		

_____ Ft. from N. Line

990 Ft. from S. Line

330 Ft. from E. Line

_____ Ft. from W. Line

Abandoned

Location _____

Rig up _____

Drilling and Remarks:

hfw

DVA

RECORD

Cased _____ in., _____ ft.

Sand Sil 319.2

Gas _____

Oil _____

Total Depth 320.1

PRODUCTION

1st 24 hrs. Nat. _____

1st 24 hrs. after shot _____

Gas _____ Cu. Ft.

Dry Hole _____

Abandoned _____

Date

MAY 19 1937 19

H. D. Hatfield

Scout