

Section 36 Township 14 Range 15-W

Well No. 3 East Reinhardt

Company National Refg.


NORTH

2




WEST

EAST

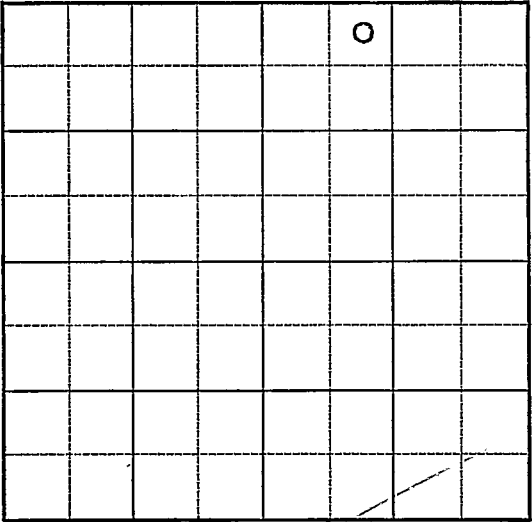

SOUTH

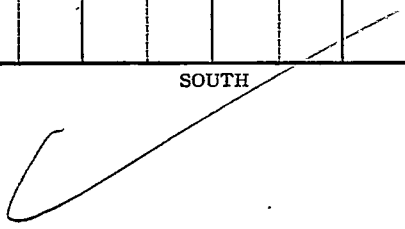

Sec. 36 Twp. 14 R. 15-W

Well No. #3 East Reinhardt Farm

National Refg. Company


330 Ft. from N. Line

_____ Ft. from S. Line

_____ Ft. from E. Line

990 Ft. from W. Line

Elev. 1741'

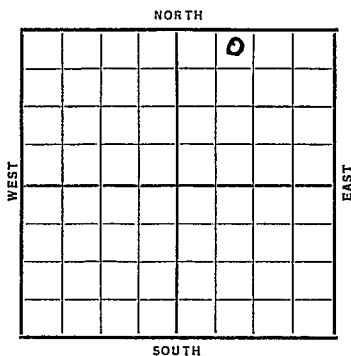

Date

REPORT

1938

1/12 20" @ 64'. Drlg. 500'.

1/20 15"-308' 13" 474'

Anhy 745' 10" 751'

Drlg. 1795'

1/28 T.D. 2390' Rng. 8"

2/4 8" 2390' Topeka 2640'

Lans. 2923 S.O.

2945-55' Drlg. 2985'

2/11 S.O. & 1 B.W. 3010-30',

Arb. 3165', 6" @ 3166'.

T.D. 3168', 750' oil 12 hrs.

2/16 6" @ 3166'.

Arb. 3165'.

T.D. 3178'.

Potential 468 bbls.

COMPLETED

Map No. 72 Sec. 36 Twp. 14 R. 15WWell No. 3 East Reinhardt

National Ref. _____

Company _____

Contractor _____

FIRST REPORT

NE NW NE

330 Ft. from N. Line

_____ Ft. from S. Line

_____ Ft. from E. Line

990 Ft. from W. Line**SECTION PLAT**

		0	

Location _____

Rig up _____

Drilling and Remarks:

20" - 64Drlg. 500**RECORD**

Cased _____ in., _____ ft.

Sand _____

Gas _____

Oil _____

Total Depth _____

PRODUCTION

1st 24 hrs. Nat. _____

1st 24 hrs. after shot _____

Gas _____ Cu. Ft.

Dry Hole _____

Abandoned _____

Date

JAN 12 1938

19

H. D. Hatfield

Scout

Russell KANSAS

Map No. _____ Sec. 36 Twp. 14 R. 15WWell No. 3 East Reinhardt

_____ National Refining _____ Company

_____ Contractor

COMPLETED

NE NW NE

330 Ft. from N. Line

_____ Ft. from S. Line

_____ Ft. from E. Line

990 Ft. from W. Line**SECTION PLAT**

		0	

Location _____

Rig up _____

Drilling and Remarks:

*POT 468***RECORD**Cased 6 in., 3166 ft.Sand Arb 3165

Gas _____

Oil 1Total Depth 3178**PRODUCTION**

1st 24 hrs. Nat. _____

1st 24 hrs. after shot _____

Gas _____ Cu. Ft.

Dry Hole _____

Abandoned _____

Date

FEB 16 1938

19

H. D. Hatfield

Scout