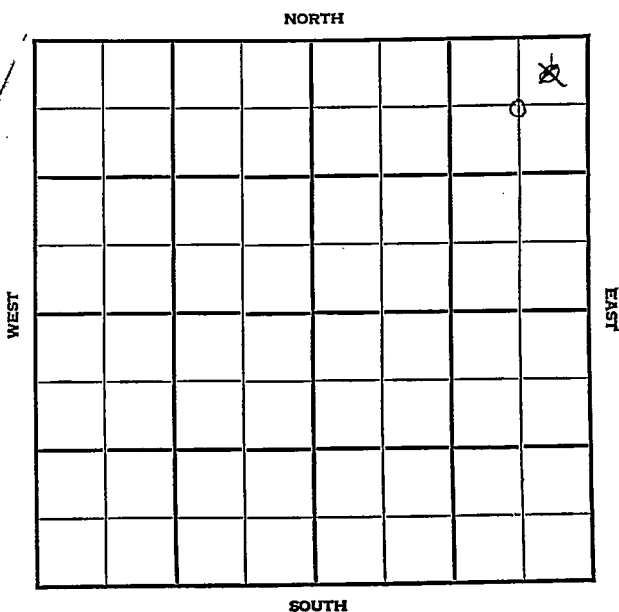


KANSAS

Section 36 Township 14 Range 15WWell No. #1, Rienhardt "A" EastCompany C R A

KANSAS Russell

Sec. 36 Twp. 14 R. 15W

Well No. #4 Rienhardt "A" East Farm

C. R. A. Company

Big Creek


330 Ft. from N. Line

 Ft. from S. Line

330 Ft. from E. Line

 Ft. from W. Line

NE/C

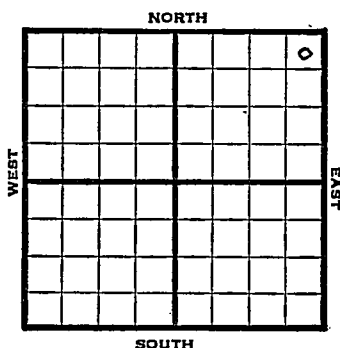

1947	Elev. 1768' REPORT
11/19	Spud.
11/25	8" @ 880' Drlg. 2210'
12/3	Lansing 2948' Gorham 3189' Arbuckle 3199' TD 3201' 5" @ 3199' RUST
12/10	Drlg. 3317' water.
12/17	Arbuckle 3195' 5" @ 3195 Reagan 3201 Pump 5 oil / 180 W ' Pot TD 3217 Gravity 37
	COMPLETED

~~Kanna~~Map No. _____ Sec. 36 Twp. 14 R. 15WWell No. 4 Rienhardt "A" EastC R A CompanyFIRST REPORT Contractor

NE/C

330

_____ Ft. from N. Line

_____ Ft. from S. Line

330 Ft. from E. Line

_____ Ft. from W. Line

SECTION PLAT

			o

Russell County

Location _____

Rig up _____

Drilling and Remarks:

Spud

RECORD

Cased _____ in., _____ ft.

Sand _____

Gas _____

Oil _____

Total Depth _____

PRODUCTION

1st 24 hrs. Nat. _____

1st 24 hrs. after shot _____

Gas _____ Cu. Ft.

Dry Hole _____

Abandoned _____

Date

NOV 1 0 1947 19S. J. LEWIS

Scout

Map No. 72 Sec. 36 Twp. 14 R. 15W

Well No. 4 Rienhardt "A" East

C R A


Company

COMPLETE

Contractor

NE/C

E 11768
SECTION PLAT

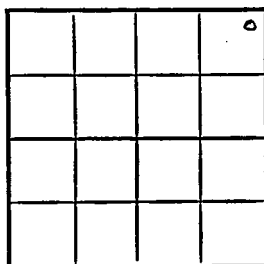

330 Ft. from N. Line

 Ft. from S. Line

330 Ft. from E. Line

 Ft. from W. Line

Russell County

Location

Rig up

Drilling and Remarks:

Aug 31/95

5-10-195

Reagan 3201

Puny soil +

18014 Pdx

27 2/3

RECORD

Cased in., ft.

Sand

Gas

Oil

Total Depth 3217

PRODUCTION

1st 24 hrs. Nat.

1st 24 hrs. after shot

Gas Cu. Ft.

Dry Hole

Abandoned

Date

DEC 1 7 1947

19

S. J. LEWIS

Scout