


Section 36 Township 14 Range 15WWell No. #1 Reinhardt (A)Company Cooperative Refinery Assn.

NORTH

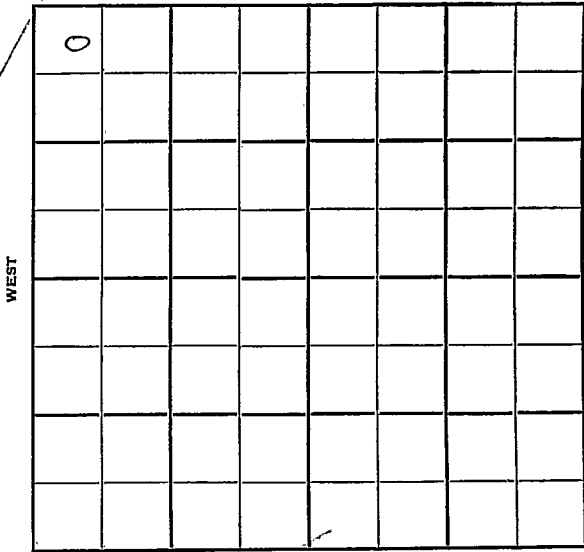

WEST

EAST

SOUTH

Russell

KANSAS

Sec. 36 Twp. 14 R. 15W

Well No. #4 Reinhardt (A) Farm

Cooperative Refinery Assn. Company

Contractor

Big Creek


330' Ft. from N. Line

Ft. from S. Line

Ft. from E. Line

495' Ft. from W. Line

NW NW NW

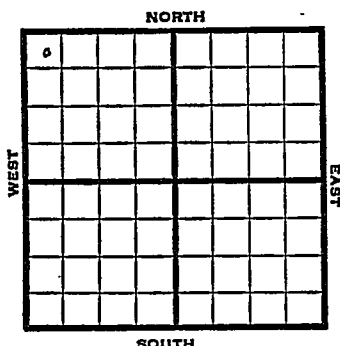

1951

Elev. 1790' REPORT

10/17

Location

11/28

Spud 11-1-51
Oil Well TD 3218
Anhy 805
8" @ 812
Heeb. 2918 Ians. 2974
DST 2974-3022 open 1 hr.
Rec. 75' mud
Arb. 3216-18 TD
5" @ 3217 FU 830' oil 2 hr.
S/ 52 bo 3½ hr.
Comp. 100 BOPD

COMPLETED

County Russell State KansasSec. 36 (Blk.) 14 (Sur.) 15W Map No.
(Twp.) (Rge.)Operator Cooperative Refinery AssnWell No. 4 Farm Reinhardt (A)Elev. _____ Location NW NW NW

0							
FIRST REPORT							

330 Ft. From N Line NW495 Ft. From W Line Quarter1st. Report OCT 17 1951

Completion. _____

Remarks _____

C.R.A. - Location

Spudding Date _____

Drlg. Data Big CreekLocation

County Russell State Kansas
 Sec. 36 (Blk.) 14 (Sur.) 15W Map No.
 Operator Cooperative Refinery Assn.
 Well No. 4 Farm Reinhardt "A"
 Elev. 1790 Location NW NW NW

0						

COMPLETE

330 Ft. From N Line NW
495 Ft. From W Line Quarter
 Ist. Report
 Completion NOV 28 1951
 Remarks Big Creek Pool
CRA - Contr.
 Spudding Date 11-1-51

Drlg. Data Oil well TD 3218
Anhy 805 8" @ 812 Heeb. 2918
Lans. 2974 DST 2974-3022 open 1 hr.
Rec. 75' mud Arb. 3216-18 TD 5" @ 3217
FU 830' oil 2 hr. S/ 52 bo 3½ hr.
Comp. 100 bopd