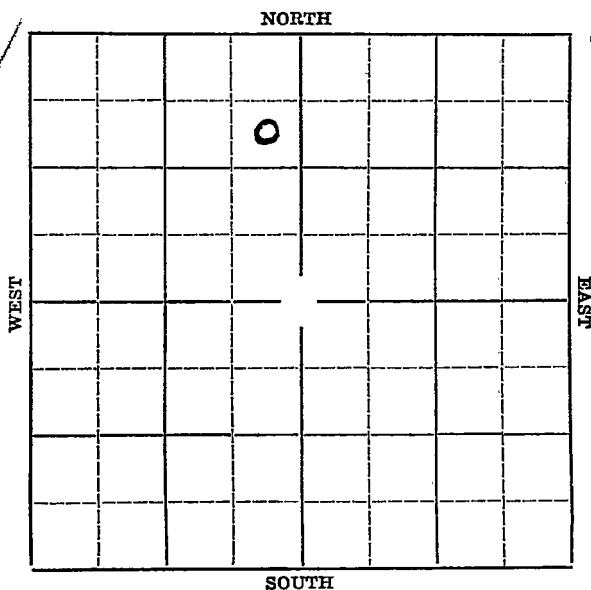


KANSAS

Russell


Section 36 Township 14 Range 15-WWell Number 2 West Reinhardt "A"Company National Ref.

Sec. 36 Twp. 14 R. 15-WWell No. #2 West Reinhardt "A" Farm
National Ref. _____ Company _____990 Ft. from N. Line

_____ Ft. from S. Line

330 Ft. from E. Line

_____ Ft. from W. Line

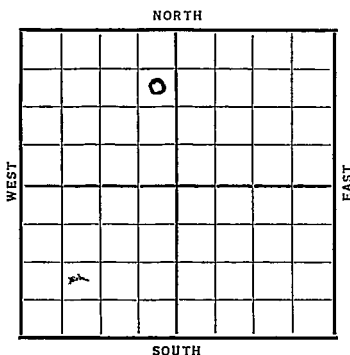Date
1937

REPORT

3/3

Rig

3/11

Rigging up.

3/18

15" @ 340' WOC

3/25

12" @ 795'. Drlg. 1025'.

4/2

Drlg. 2405'

4/8

8" @ 2474' Lansing 2900'

TD 2950' under ream 8"

4/16Gorham 3186'. TD 3204-3000' oil
in hole4/21

Gorham 3186'.

T.D. 3204'.

Potential 1486 natural.

COMPLETED

KANSAS

Russell

Map No. 72 Sec. 36 Twp. 14 R. 15WWell No. 2 West Reinhardt "A"National Ref. Company

Contractor

SECTION PLAT

	o		

990 Ft. from N. Line

_____ Ft. from S. Line

330 Ft. from E. Line

_____ Ft. from W. Line

FIRST REPORT

Location _____

Rig up _____

Drilling and Remarks:

Rig

RECORD

Cased _____ in., _____ ft.

Sand _____

Gas _____

Oil _____

Total Depth _____

PRODUCTION

1st 24 hrs. Nat. _____

1st 24 hrs. after shot _____

Gas _____ Cu. Ft.

Dry Hole _____

Abandoned _____

Date

MAR 3 1904

19

S. J. LEWIS Scout

KANSAS *Russell*Map No. _____ Sec. *36* Twp. *14* R. *15W*Well No. *2. J. S. Reinhardt & Co.**National Ref.* Company

Contractor

SECTION PLAT

	0		

990 Ft. from N. Line

_____ Ft. from S. Line

330 Ft. from E. Line

_____ Ft. from W. Line

COMPLETED

Location _____

Rig up _____

Drilling and Remarks:

*Gorham 3186**Potential**1486 natural***RECORD**

Cased _____ in., _____ ft.

Sand _____

Gas _____

Oil _____

Total Depth *3204***PRODUCTION**

1st 24 hrs. Nat. _____

1st 24 hrs. after shot _____

Gas _____ Cu. Ft.

Dry Hole _____

Abandoned _____

Date

APR 21 1937

19

S. J. LEWIS Scout