

KANSAS

Russell


Form 51-5M-7-40-Palace

Section 36 Township 14 Range 14-W

Well No. #4 Michel

Company Gore et al

NORTH Hall Gurney Pool

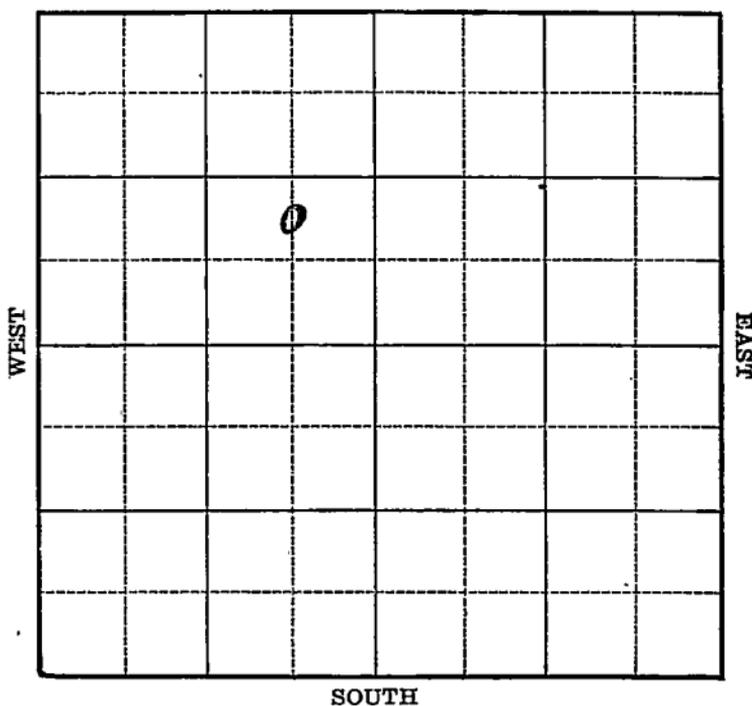

Sec. 36 Twp. 14 R. 14-W

Well No. #4 Michel Farm

Gore et al Company

(Hall-Gurney)


_____ Ft. from N. Line

990 Ft. from S. Line

660 Ft. from E. Line

_____ Ft. from W. Line

Elev. 1756

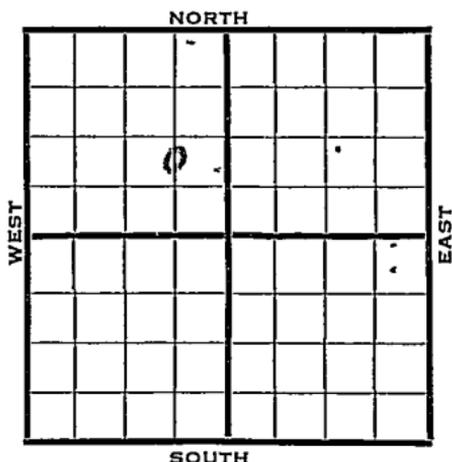

1941	REPORT
1/22	Cellar.
1/30	"
2/6	"
2/13	"
2/20	Spud.
2/27	12" - 450' Anhy 713'
	10" - 726' Drlg. 1480'
3/6	Drlg. 2335'
3/13	8" - 2405'
	SD 2425' repairs.
3/20	Drlg. 2833'
3/27	Lans. 2900' 6" - 2920'
	T.D. 2945' WOC.
4/2	T.D. 2950' 1000 acid.

OVER

1941

4/9

Lans. 2900'

6" - 2920'

T.D. 2950'

10,000 acid.

Potential 329 bbls., pump.

38.3 Gravity

COMPLETED

Map No. 72 Sec. 36 Twp. 14 R. 14WWell No. 4 MichelGore etal

Company

Contractor

FIRST REPORT

C N L SE NW

_____ Ft. from N. Line

990 Ft. from S. Line660 Ft. from E. Line

_____ Ft. from W. Line

HALL GURNEY POOL

SECTION PLAT

	o		

Location _____

Rig up _____

Drilling and Remarks:

CELLAR

RECORD

Cased _____ in., _____ ft.

Sand _____

Gas _____

Oil _____

Total Depth _____

PRODUCTION

1st 24 hrs. Nat. _____

1st 24 hrs. after shot _____

Gas _____ Cu. Ft.

Dry Hole _____

Abandoned _____

Date

JAN 22 1941 19S. J. LEWIS Scout

Misc Small Maps
Cards
Tracing
France Map
Columbough Map
Moody Map
Geological Dept.
Moody + Cook

Handwritten signatures:
DMS
DMS
J
DMS
J

Misc. Small Maps	<i>DMJ</i>
Cards	<i>DMJ</i>
Tracing	<i>DMJ</i>
France Map	<i>DMJ</i>
Scarborough Map	<i>DMJ</i>
Moody Map	<i>DMJ</i>
Geological Dept.	
Moody Flat Book	