

KANSAS

Russell


Form 51-5M-7-40-Palace

Section 36 Township 14 Range 14-W

Well No. #2 Michel

Company Gore et al

NORTH Gurney Pool

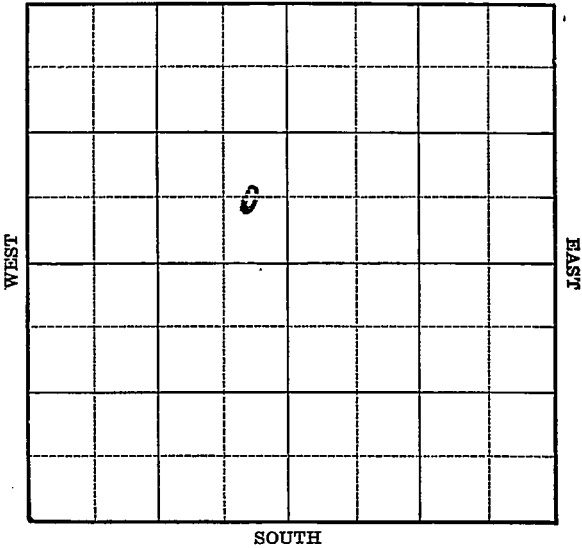

KANSAS

Russell

Sec. 36 Twp. 14 R. 14WWell No. 2-Michel FarmGore et al Company


(Gurney Pool)

Ft. from N. Line

660 Ft. from S. Line330 Ft. from E. Line

Ft. from W. Line

Elev. 1754

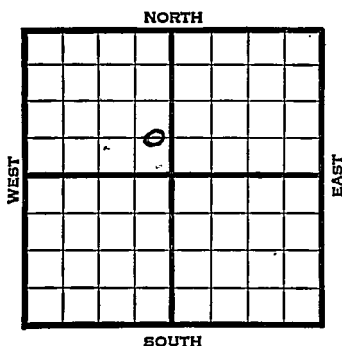

1940

REPORT

8/28

Location

9/5

"

9/12

"

9/19

"

9/26

Cable rig.

10/3

15" - 40'

Spud 150'

10/10

12" - 455' Anhy 700'

10" - 737' Drlg. 830'

10/17

Drlg. 1860'

10/24

2240' U.R. 8".

10/31

8" - 2444' Drlg. 2525'

11/7

SO 2995-2600 & at 2860'

Lans. 2918' Oil 2918-20'

T.D. 2925' 200' oil 1 hour.

900' oil total fill up.

6" - 2918' WOC.

11/14

Drlg. 3085' Going to test lower formation.

11/21

Gorham 3158-60' T.D. 5" - 3158' 1800' oil 4 hours.

OVER

1940

11/27

TD 3163' 5" - 3156'
2700' oil.

12/4

Gorham 3158'

5" - 3156'

T.D. 3163'

Potential 2014 bbls., pump.

40.2 Gravity

COMPLETED

KANSAS

Form 26—200 Bks.—1-40—Palace

Russell

Map No. _____ Sec. 36 Twp. 14 R. 14W

Well No. 2 Michel

Gore etal Company

Contractor

FIRST REPORT

C E L S E N W

SECTION PLAT

		o	

_____ Ft. from N. Line

660 Ft. from S. Line

330 Ft. from E. Line

_____ Ft. from W. Line

GURNEY POOL

Location X

Rig up _____

Drilling and Remarks: _____

RECORD

Cased _____ in., _____ ft.

Sand _____

Gas _____

Oil _____

Total Depth _____

PRODUCTION

1st 24 hrs. Nat. _____

1st 24 hrs. after shot _____

Gas _____ Cu. Ft.

Dry Hole _____

Abandoned _____

Date

AUG 28 1940 19

S. I. LEWIS Scout

Misc. Small Maps
Cards
Tracing
France Map
Scarborough Map
Moody Map
Geological Dept.
Moody Flat Book

Handwritten signature

Handwritten initials

Handwritten initials

Handwritten initials

Map No. 72 Sec. 36 Twp. 14 R. 14WWell No. 2 MichelGore etal

Company

Contractor

COMPLETED**C E L S E N W** Ft. from N. Line660 Ft. from S. Line330 Ft. from E. Line Ft. from W. Line**GURNEY POOL****SECTION PLAT**

		o	

Location Rig up

Drilling and Remarks:

*3 Dr kam 3158**5" C 3156**Pump 2014 P.Y.**40.2 Gr***RECORD**Cased in., ft.Sand Gas Oil Total Depth 3163**PRODUCTION**1st 24 hrs. Nat. 1st 24 hrs. after shot Gas Cu. Ft.Dry Hole Abandoned

Date

DEC 4 1940 19S. J. LEWIS Scout

RAM
 Misc. Small Maps
 Cards
 Tracing
 France Map
 Scarborough Map
 Froody Map
 Zoological Dept.
 Moody Flat Book