


Section 36 Township 14 Range 14-W

Well Number 1 - Strecker "B"

*Cities-Service*

Company ~~Empire~~

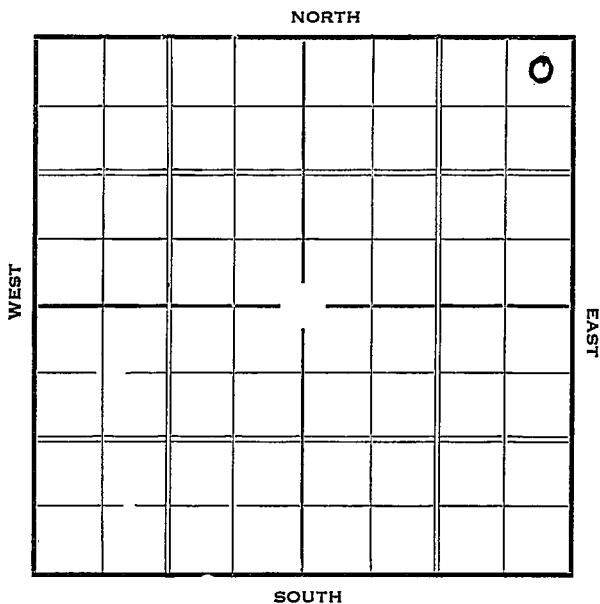

O. W. D. D



1937

6/23 8" @ 2870'.  
Oswald 2866'.  
T.D. 2971'.  
13,000 acid (Total)  
Pot. 351 oil.  
6% water.

COMPLETED

O. W. D. D

1939  
9/27

Old T.D. 2971'  
2998; 6 bbls. fluid per hour.  
7" - 3022'  
3035;  $\frac{1}{2}$  bbl. oil & trace water  
per hour.  
3093-97' T.D. free oil.

10/5

" " " "

10/12 7" - 3089' T.D. 3097'

10/19 Quartzite 3125'  
SSO 3154-55' T.D. 3164'  
P. B. 3070' Set 7" WOC.

10/26 20 shots 3039-48'  
20 shots 3044-47' 5000 acid.  
Pump 27 bbls. fluid, 57% water  
in 13 hours.

11/2 " " "

11/9 Shut down.

11/15 Quartzite 3125'  
T.D. 3164'  
P. B. to 3070'  
40 shots 3039-48  
5000 acid.  
Pump 16 oil & 8 water.

COMPLETED

Russell KANSAS

Map No. \_\_\_\_\_ Sec. 36 Twp. 14 R. 14<sup>W</sup>Well No. 1 - Strecker "B"Empire Company

Contractor

## FIRST REPORT

## SECTION PLAT

330 Ft. from N. Line

\_\_\_\_\_ Ft. from S. Line

330 Ft. from E. Line

\_\_\_\_\_ Ft. from W. Line

			0

Location \_\_\_\_\_

Rig up \_\_\_\_\_

Drilling and Remarks:

B. Rot Rig

## RECORD

Cased \_\_\_\_\_ in., \_\_\_\_\_ ft.

Sand \_\_\_\_\_

Gas \_\_\_\_\_

Oil \_\_\_\_\_

Total Depth \_\_\_\_\_

## PRODUCTION

1st 24 hrs. Nat. \_\_\_\_\_

1st 24 hrs. after shot \_\_\_\_\_

Gas \_\_\_\_\_ Cu. Ft.

Dry Hole \_\_\_\_\_

Abandoned \_\_\_\_\_

Date

APR 28 1937

19

H. Hatfield Scout

Russell KANSAS

Map No. 72 Sec. 26 Twp. 14 R. 14<sup>W</sup>

Well No. 1-Stricker "B"

Empire Company  
Contractor

**COMPLETED**

330 Ft. from N. Line  
     Ft. from S. Line  
330 Ft. from E. Line  
     Ft. from W. Line

**SECTION PLAT**

			0 "A" LSE

Location \_\_\_\_\_

Rig up \_\_\_\_\_

Drilling and Remarks:

13,000 Acid  
(TOTAL)

pat 351 oil

670 wzt.

**RECORD**

Cased 8 in., 2870 ft.  
Sand Oswald 2866  
Gas \_\_\_\_\_  
Oil \_\_\_\_\_  
Total Depth 2971

**PRODUCTION**

1st 24 hrs. Nat. \_\_\_\_\_  
1st 24 hrs. after shot \_\_\_\_\_  
Gas \_\_\_\_\_ Cu. Ft.  
Dry Hole \_\_\_\_\_  
Abandoned \_\_\_\_\_

Date

JUN 23 1937 19 H. D. Hatfield Scout

Map No. \_\_\_\_\_ Sec. **36** Twp. **14** R. **14W**

Well No. **1 Strecker "B"**

**Cities Service Oil** Company

Contractor \_\_\_\_\_

**FIRST REPORT**

**NE/C**

**SECTION PLAT**

			o

**330** Ft. from N. Line

\_\_\_\_\_ Ft. from S. Line

**330** Ft. from E. Line

\_\_\_\_\_ Ft. from W. Line

**HALL POOL**

Location \_\_\_\_\_

Rig up \_\_\_\_\_

Drilling and Remarks:

**OWDD-OTD 2971**

**2998; 6bbl fluid**  
per hour

**7" - 3022**

**3035; 1/2 bbl oil &**  
trace wat. per hr

**3093-97 TD., free**  
oil

**RECORD**

Cased \_\_\_\_\_ in., \_\_\_\_\_ ft.

Sand \_\_\_\_\_

Gas \_\_\_\_\_

Oil \_\_\_\_\_

Total Depth \_\_\_\_\_

**PRODUCTION**

1st 24 hrs. Nat. \_\_\_\_\_

1st 24 hrs. after shot \_\_\_\_\_

Gas \_\_\_\_\_ Cu. Ft.

Dry Hole \_\_\_\_\_

Abandoned \_\_\_\_\_

Date

**SEP 27 1939** 19 \_\_\_\_\_

**S. J. LEWIS**

Scout

Map No. 72 Sec. 36 Twp. 14 R. 14W

Well No. 1 Stracker "B"

Cities Service Oil Company

Contractor

**COMPLETED**

**NE/C**

330 Ft. from N. Line

\_\_\_\_\_ Ft. from S. Line

330 Ft. from E. Line

\_\_\_\_\_ Ft. from W. Line

**SECTION PLAT**

			o

**HALL POOL**

Location \_\_\_\_\_

**RECORD**

Cased \_\_\_\_\_ in., \_\_\_\_\_ ft.

Sand \_\_\_\_\_

Gas \_\_\_\_\_

Oil \_\_\_\_\_

Total Depth 3164

**PRODUCTION**

1st 24 hrs. Nat. \_\_\_\_\_

1st 24 hrs. after shot \_\_\_\_\_

Gas \_\_\_\_\_ Cu. Ft.

Dry Hole \_\_\_\_\_

Abandoned \_\_\_\_\_

Drilling and Remarks:

*Swart puts 3125*

*P.B 3070*

*40 Bks to 3039-48*

*5000 acid*

*Pump 16 oil & water*

Date

NOV 15 1939

S. J. LEWIS

Scout