

KANSAS


Form 51-5M-7-40-Palace

Russell

Section 36 Township 14 Range 14-W

Well No. #3 Strecker "B"

Company Cities Service Oil

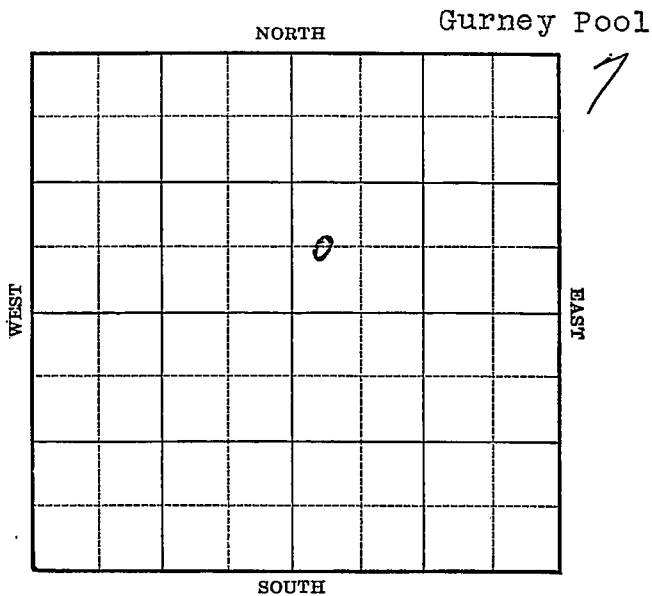


Sec. 36 Twp. 14 R. 14-WWell No. #3 Strecker "B" FarmCities Service Oil Company

(Gurney)

 Ft. from N. Line660 Ft. from S. Line Ft. from E. Line330 Ft. from W. Line

Elev. 1750

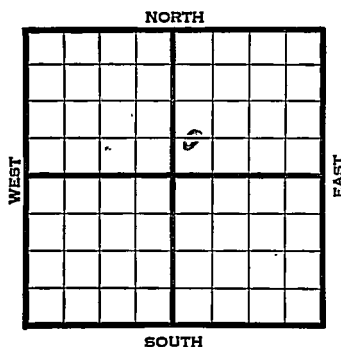

1940

REPORT

12/11

Derrick.

12/19

8" - 317' Drlg. 900'

12/26

Lans. 2891' Drlg. 2919'

1941

1/2

Gorham 3149-50' T.D.

5" - 3149' RUST.

1/8

Gorham 3151'

5" - 3151'

T.D. 3160'

Granite Wash 3158'

Potential 113 bbls., pump.

38. Gravity

COMPLETED

Map No. 72 Sec. 36 Twp. 14 R. 14WWell No. 3 Strecker "B"

Cities Service Oil Company

Contractor

FIRST REPORT

C W L SW NE

 Ft. from N. Line660 Ft. from S. Line Ft. from E. Line330 Ft. from W. Line

GURNEY POOL

SECTION PLAT

Location Rig up

Drilling and Remarks:

Derrick

RECORD

Cased in., ft.Sand Gas Oil Total Depth

PRODUCTION

1st 24 hrs. Nat. 1st 24 hrs. after shot Gas Cu. Ft.Dry Hole Abandoned

Date

DEC 11 1940 19

S. J. LEWIS

Scout

Misc. Small Maps

Cards

Tracing

France Map

Scarborough Map

Moody Map

Geological Dept.

Moody Flat Book

Map No. 72 Sec. 36 Twp. 14 R. 14WWell No. 3 Strecker "B"Cities Service Oil Company

Contractor

COMPLETED**SECTION PLAT**

C W L SW NE

____ Ft. from N. Line

660 Ft. from S. Line

____ Ft. from E. Line

330 Ft. from W. Line

GURNEY POOL

Location _____

Rig up _____

Drilling and Remarks:

*Grd ham 3/5/**5" @ 3/5/**Granite & Wash 3/5/**Pump. 113 Po Y.**38° Gr.***RECORD**

Cased _____ in., _____ ft.

Sand _____

Gas _____

Oil _____

Total Depth 3168**PRODUCTION**

1st 24 hrs. Nat. _____

1st 24 hrs. after shot _____

Gas _____ Cu. Ft.

Dry Hole _____

Abandoned _____

Date

JAN 8 1941 19

S. J. LEWIS Scout

Misc. Small Maps

Gards.....

Tracing.....

France Map.....

Coastalough Map.....

Moody Map.....

Geological Dept.

Moody Fitz Book