


Section 36 Township 14 Range 14-W

Well Number 1 - Strecker "C"

Company Empire

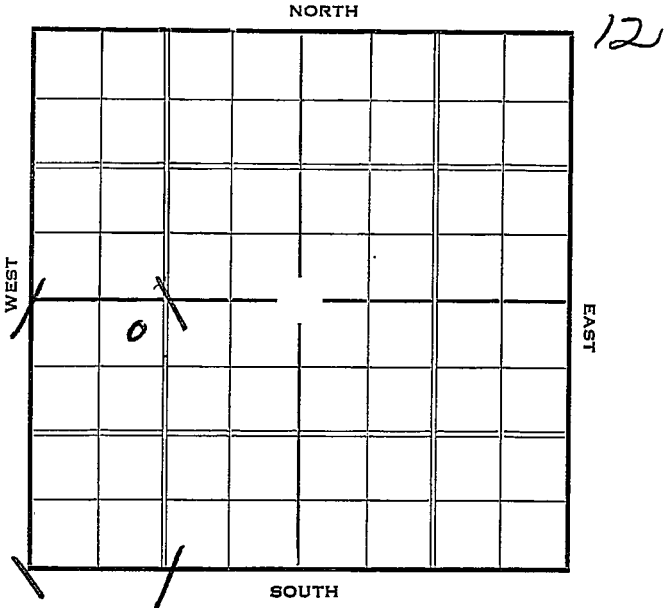

Sec. 36 Twp. 14 R. 14 -W

Well No. #1 Strecker "C" Farm

Empire Company


330 Ft. from N. Line

_____ Ft. from S. Line

_____ Ft. from E. Line

990 Ft. from W. Line

Elev. 1759

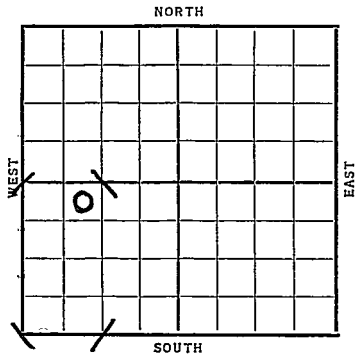

Date	REPORT
1937	
7/14	Location.
7/23	Spud.
7/30	12" @ 348'. Anhy 725'.
	Drlg. 1730'.
8/6	Drlg. 2439'.
8/13	K.C. 2905'. 8" @ 2930'. WOC.
8/20	8" @ 2930'. WOC.
8/28	Drlg. 3040'. 1/2 BWPH
9/3	Granite wash 3130'.
	T.D. 3153'. No shows.
	P.B. 2961'. Pay 2937-41'.
	200' oil.
	OVER

1937

9/8

K.C. 2905'.

Granite wash 3130'.

T.D. 3153'.

P.B. 2961'.

5000 acid.

P. 48.96 bbls. 4 hrs.

40.22 bbls. 4 hrs.

Pot. 362 bbls. oil.

Plus 15% water.

COMPLETED

KANSAS

Russell

Map No. _____ Sec. 36 Twp. 14 R. 14^w

Well No. 1 - Strecker "C"

Empire Company
Contractor

FIRST REPORT

SECTION PLAT

330 Ft. from N. Line
1 Ft. from S. Line
_____ Ft. from E. Line
940 Ft. from W. Line

	0		

Location _____

Rig up _____

Drilling and Remarks: _____

RECORD

Cased _____ in., _____ ft.

Sand _____

Gas _____

Oil _____

Total Depth _____

PRODUCTION

1st 24 hrs. Nat. _____

1st 24 hrs. after shot _____

Gas _____ Cu. Ft.

Dry Hole _____

Abandoned _____

Date

JUL 14 1937 19

H. D. Hatfield Scout

Map No. _____ Sec. 36 Twp. 14 R. 14W

Well No. 1-Stricker 'C'

Empire Oil Company

Contractor _____

COMPLETED

SECTION PLAT

o			

330 Ft. from N. Line

_____ Ft. from S. Line

_____ Ft. from E. Line

990 Ft. from W. Line

Location _____

Rig up _____

Drilling and Remarks:

P. B. 2961.
5000 acid
P. 48.96 4 hrs
40.22 4 hrs
Rot. 362 bbls
plus 15% water

RECORD

Cased _____ in., _____ ft.

Sand P.C. 290.5

~~Gas~~ Granite Wash 3130

Oil _____

Total Depth 3153

PRODUCTION

1st 24 hrs. Nat. _____

1st 24 hrs. after shot _____

Gas _____ Cu. Ft.

Dry Hole _____

Abandoned _____

Date

SEP 8 1937 19

H. D. Hatfield

Scout