KANSAS

Form 51—5M—7-39—Palace


Russell

Section 36 Township 14 Range 14-W

Well No. #2 F. Michael "B"

Company Stanolind

Hall Pool

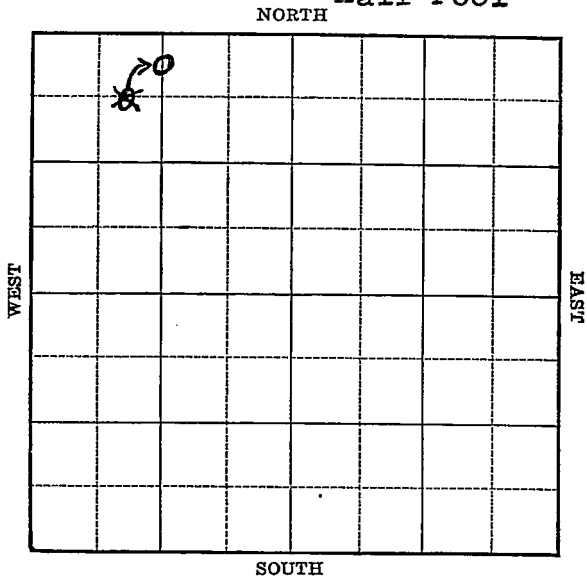

FORM 252-A 5M **KANSAS** Russell

Sec. 36 Twp. 14 R. 14-W

Well No. #2 F. Michael "B" Farm

Stanolind Company


(Hall)

~~660~~ 330 Ft. from N. Line

Ft. from S. Line

Ft. from E. Line

~~990~~ 1320 Ft. from W. Line

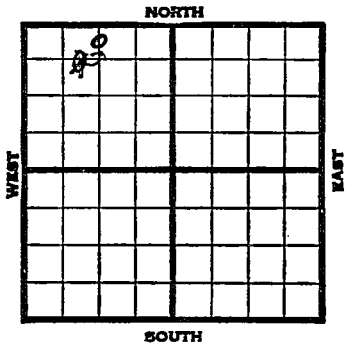

Elev. 1741

1940	REPORT
1/31	Location
2/8	"
2/15	"
2/23	20" - 39' Drlg. 270'
2/29	13" - 490' Drlg. 650'
3/8	Anhy 704' Drlg. 1585'
3/14	8" - 2220' Drlg. 2251'
3/21	Topeka 2575' 8" - 2325'
	Drlg. 2715'
3/28	Lans. 2870' 7" - 2875'
	T.D. 2918' WOC.
4/4	1700' oil. 7000 acid.
4/10	Lansing 2870'
	T.D. 2918'
	7000 acid.
	Pump 2079 bbls.
	COMPLETED

Form 26—1M Bks.—2-29 Russell KANSAS

Map No. 72 Sec. 36 Twp. 14 R. 14W

Well No. 2 F. Michael "B"

Stanolind Company

Contractor

FIRST REPORT

C E½ NW NW

660 Ft. from N. Line


Ft. from S. Line

Ft. from E. Line

990 Ft. from W. Line

HALL POOL

SECTION PLAT

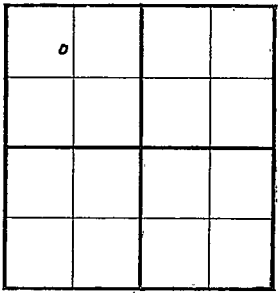

Location X

Rig up

Drilling and Remarks:

RECORD

Cased in., ft.

Sand

Gas

Oil

Total Depth

PRODUCTION

1st 24 hrs. Nat.

1st 24 hrs. after shot

Gas Cu. Ft.

Dry Hole

Abandoned

Date

JAN 31 1940 19

S. J LEWIS Scout

Form 26—1M Bks.—2-29 Russell KANSAS


Map No. 72 Sec. 36 Twp. 14 R. 14W

Well No. 2 F. Michael "B"

Stanolind Company

CORRECTION Contractor

SECTION PLAT

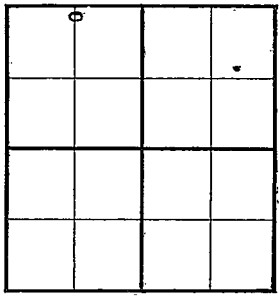

C N L NW

330 Ft. from N. Line

_____ Ft. from S. Line

_____ Ft. from E. Line

1320 Ft. from W. Line

HALL POOL

Location _____

Rig up _____

Drilling and Remarks:

Reported

C E½ NW NW

RECORD

Cased _____ in., _____ ft.

Sand _____

Gas _____

Oil _____

Total Depth _____

PRODUCTION

1st 24 hrs. Nat. _____

1st 24 hrs. after shot _____

Gas _____ Cu. Ft.

Dry Hole _____

Abandoned _____

Date

FEB 7 1940 19 S. J. LEWIS Scout

Form 26—200 Bks.—1-40—Palace

KANSAS

Russell

Map No. 72 Sec. 36 Twp. 14 R. 14W

Well No. 2 F. Michael "B"

Stanolind Company

Contractor

COMPLETED

C N L NW

330 Ft. from N. Line


Ft. from S. Line

Ft. from E. Line

1320 Ft. from W. Line

HALL POOL

SECTION PLAT

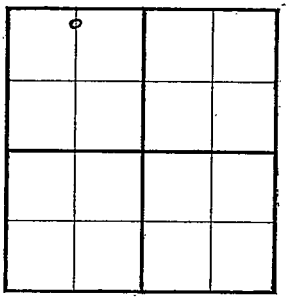

Location

Rig up

Drilling and Remarks:

7000 acid

Pump 2079 bbls.

RECORD

Cased in., ft.

Sand Lansing 2870

Gas

Oil

Total Depth 2918

PRODUCTION

1st 24 hrs. Nat.

1st 24 hrs. after shot

Gas Cu. Ft.

Dry Hole

Abandoned

Date

APR 10 1940 19

S. J. LEWIS Scout