

KANSAS

Form 51-5M-7-39-Palace


Russell

Section 36 Township 14 Range 14-W

Well No. #1 F. Michel "B"

Company Stanolind

NORTH Hall Pool

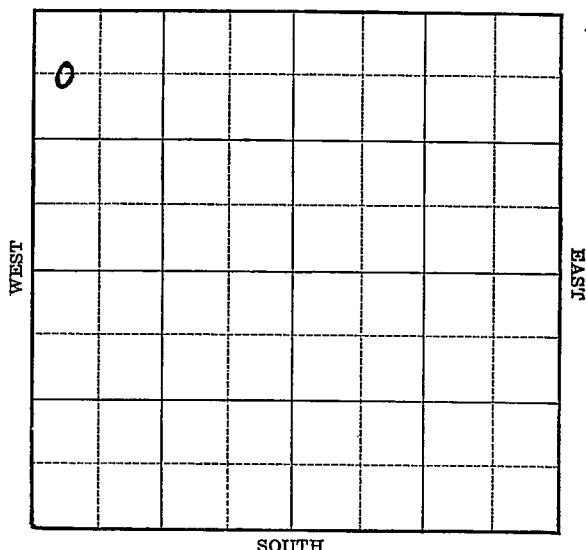

KANSAS

Russell

Sec. 36 Twp. 14 R. 14-WWell No. #1 F. Michel "B" Farm
Stanolind Company

(Hall)


660 Ft. from N. Line

Ft. from S. Line

Ft. from E. Line

330 Ft. from W. Line

Elev. 1762

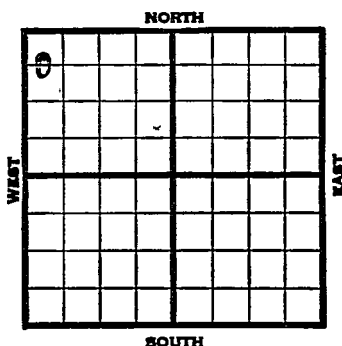

1939

REPORT

10/4

Location

10/12

"

10/19

"

10/26

"

11/2

"

11/9

"

11/16

Cable rig.

11/23

20" - 61'

Drlg. 285'

11/29

16" - 318' 13" - 503'

Drlg. 730'

12/7

Anhy 735' 10" - 740'

Drlg. 1250'

12/14

Drlg. 1970'

12/21

Tarkio 2282' Topeka 2606'

Drlg. 2633'

12/28

Lans. 2898' 7" - 2909'

H.F.W. 3004, 3020' T.D. U.R. 7"

1940

1/4

7" - 3028' SO 3155-56' T.D.

Testing.

OVER

1940

1/11

Basal sand 3153' 7" - 3145'
T.D. 3156' 1400' oil.

1/18

" " " "

1/24

Lans. 2898'

7" - 3145'

Basal Sand 3153'

4 shots 2507-08'

T.D. 3156'

Pump 770 bbls.

COMPLETED

Map No. _____ Sec. 36 Twp. 14 R. 14WWell No. 1 F. Michel "B"Stanolind

Company

Contractor

FIRST REPORT

C $W\frac{1}{2}$ NW NW

SECTION PLAT

0			

660 Ft. from N. Line

_____ Ft. from S. Line

_____ Ft. from E. Line

330 Ft. from W. Line

HALL POOL

Location X

RECORD

Cased _____ in., _____ ft.

Sand _____

Gas _____

Oil _____

Total Depth _____

PRODUCTION

1st 24 hrs. Nat. _____

1st 24 hrs. after shot _____

Gas _____ Cu. Ft.

Dry Hole _____

Abandoned _____

Date

OCT 4 1939 19S. J. LEWIS Scout

Misc Small Maps

Cards

Tracing

France Map





Map No. 72 Sec. 36 Twp. 14 R. 14WWell No. 1 F. Michel "B"Stanolind Company

Contractor

COMPLETED

C $W\frac{1}{2}$ NW NW660 Ft. from N. Line Ft. from S. Line Ft. from E. Line330 Ft. from W. Line

HALL POOL

SECTION PLAT

Location Rig up

Drilling and Remarks:

L. on 2898
7" C 3145.
Basal Sand 3153
4 Shots 2507-08
Pump 770 88 lb.

RECORD

Cased in., ft.Sand Gas Oil Total Depth 3156

PRODUCTION

1st 24 hrs. Nat. 1st 24 hrs. after shot Gas Cu. Ft.Dry Hole Abandoned

Date

JAN 24 1940 19

S. J. LEWIS

Scout

Misc. Small Maps	Done
Cards	Done
Tracing	Done
France Map	Done
Scarborough Map	Done
Moody Map	Done
Ecological Dept.	
Moody Flat Book	