

Russell

KANSAS


Form 51-5M-7-39-Palace

O.W.W.O.

Section 36 Township 14 Range 14-W

Well No. #3 Michael "B"

Company Stanolind

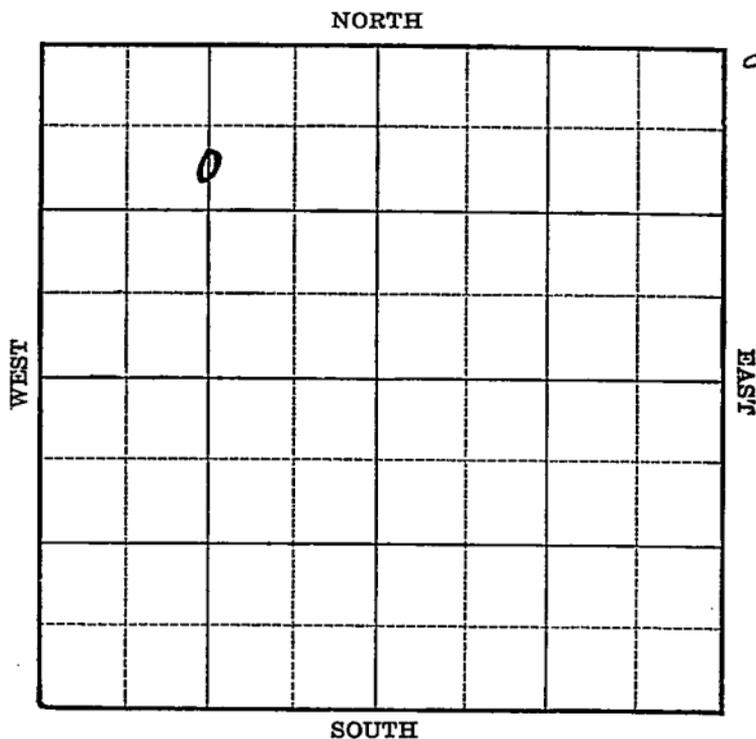

Sec. 36 Twp. 14 R. 14-W

Well No. #3 Michael "B" Farm
Stanolind Company

(Hall)


990

Ft. from N. Line

Ft. from S. Line

Ft. from E. Line

1320 Ft. from W. Line

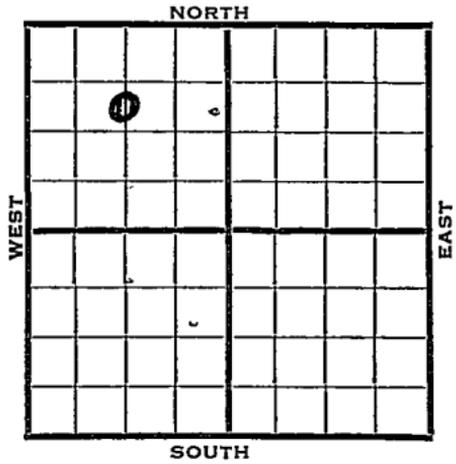

Elev. 1764

C S/2 N/2 NW

1940.	REPORT
4/3	Location
4/12	R. U. cable tools.
4/18	20" - 48' WOC.
4/25	13" - 493' Drlg.
5/2	Anhy 715' 10" - 725' Drlg. 1640'
5/9	S.O. 2280-90' 2430' run 8".
5/16	Topeka 2685' 8" - 2894' Lans. 2797' Coring 2933'
5/23	Basal sand 3150-52' T.D. 160' oil 1/2 hour. U.R. 7".
5/29	7" - 3151' T.D. 3155' WOC.
6/5	Basal Sand 3156' TX 7" - 3151' T.D. 3159' Potential 667 bbls., pump
COMPLETED	
OVER	

1956
3/28

O.W.W.O.

OTD 3159' 7" @ 3154 CO
S/4.56 BFPH 2 hr. 75% wtr. 250 A
1000 A SP 3150 16/2990-94 dry
16/2946-50 16/2928-32 dry
1000 A 1/67 BO 6 hr. 3.07 BFPH 5 hr.
50% wtr.
Comp. 34 BOPD 144 BW
Lans. 2897', Gorham 3156'
TD 3159'

**FIRST REPORT
COMPLETED**

Map No. 72 Sec. 36 Twp. 14 R. 14WWell No. 3 Michael "B"Stanolind

Company

Contractor

FIRST REPORT

C $S\frac{1}{2}$ $N\frac{1}{2}$ NW

SECTION PLAT

	o		

990 Ft. from N. Line

_____ Ft. from S. Line

_____ Ft. from E. Line

1320 Ft. from W. Line

HALL POOL

Location X

Rig up _____

Drilling and Remarks:

RECORD

Cased _____ in., _____ ft.

Sand _____

Gas _____

Oil _____

Total Depth _____

PRODUCTION

1st 24 hrs. Nat. _____

1st 24 hrs. after shot _____

Gas _____ Cu. Ft.

Dry Hole _____

Abandoned _____

Date

APR : 1940 19

S. J. LEWIS Scout

Misc Small Maps
Cards
Tracing
France Map
Scarborough Map
Moody Map
Geological Dept.
Moody Flat Lock

Handwritten signatures and initials:
- A large signature, possibly "DARY", is written over the top of the form.
- The word "Cards" has a signature written over it.
- The word "Tracing" has initials "JMS" written over it.
- The word "France Map" has a signature written over it.
- The word "Scarborough Map" has initials "JMS" written over it.

Map No. 72 Sec. 36 Twp. 14 R. 14WWell No. 3 Michael "B"Stanolind

. Company

Contractor

COMPLETEDC $S\frac{1}{2}$ $N\frac{1}{2}$ NW990 Ft. from N. Line

_____ Ft. from S. Line

_____ Ft. from E. Line

1320 Ft. from W. Line**SECTION PLAT**

HALL POOL

Location _____

Rig up _____

Drilling and Remarks:

*Base Sand 3856**7" 3857**Pump 667 ft.***RECORD**

Cased _____ in., _____ ft.

Sand _____

Gas _____

Oil _____

Total Depth 3159**PRODUCTION**

1st 24 hrs. Nat. _____

1st 24 hrs. after shot _____

Gas _____ Cu. Ft.

Dry Hole _____

Abandoned _____

Date

JUN 5 1940 19S. J. LEWIS Scout

Misc. Small Maps.....
Cards.....
Tracing.....
France Map.....
Scarborough Map.....
Moody Map.....
Geological Dept.
Moody Plat Book

O.W.W.O.

O.W.O.

FORM 513 REV. SUNRAY

County Russell Elev. _____
 Sec. 36 Twp. 14 Rge. 14W
 Company Standlind
 Farm Name F. Michel "B" No. 3

TOPS	DEPTH	LOG	DATUM
Anh.			
Tp.			
H.			
Tr.			
Dg.			
Bl.			
L.	2897		
K.C.			
B.K.C.			
Ce.			
C. <u>Gorham</u>	3156		
M.			
M.			
K.			
Mz.			
Mo.			
V.			
S.			
S.			
A.			
R.			
Pe.			
G.			
T.D.	3159		

Loc. in Sec. _____
C S $\frac{1}{2}$ N $\frac{1}{2}$ NW
 Geol. _____
 Contr. _____
 Pool _____

FIRST REPORT	
COMPLETE	
MAR 28 56	

Date Comm. OTD 3159 7" @ 3154 CO S/ 4.56 bfph
 2 hr. 75% wtr. 250 A 1000 A
 SP 3150 16/ 2990-9h drv 16/ 29h6-50
 16/ 2928-32 dry 1000 A 1/67 bo
 6 hr. 3.07 bfph 5 hr. 50% wtr.
 Comp. 3h bopd 144 bw

Co.
Lse.
I
No.
Sec.
T.
R.

APR 9 1958

AVI. RVR.