

Russell KANSAS

Section 36 Township 14 Range 14W

Well No. #5 Keil

Company Texas

NORTH

16

WEST

EAST

SOUTH

Russell

KANSAS

Sec. 36 Twp. 14 R. 14W

Well No. #5 Keil Farm
Texas


Hall-Gurney (Powell & Peters, Contr.) Company
Pool

 Ft. from N. Line

990' Ft. from S. Line

990' Ft. from E. Line

 Ft. from W. Line

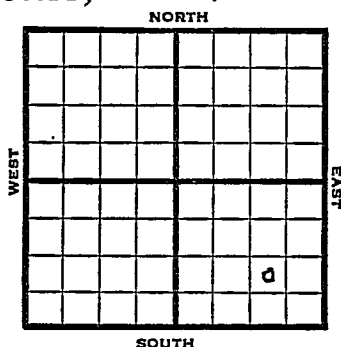

NW SE SE

1949	Elev 1733'	REPORT
11/23	10" @ 706'	
	Drlg. 1770'	
11/29	Lansing 2899'	
	Drlg 2997'	
12/7	Reagan 3139-44'	
	TD 3144'	
	7" @ 3142'	
12/14	TD 3166'	3150' W 8 hrs.
12/21	PB 77	
12/28	"	
1950		
1/18	TD 3166'	
	10" @ 706'	
	7" @ 3142'	
	TD 3166'	
	Tested wtr.	
	Plug back to 3052	
	No shows.	
	Plug back to 3070'	
	Comp	
	Perf 17/3060-64	No shows.
	33/2996-3004	
	Plug back to 2987	
	Perf 4/2980-86	show of oil & wtr.
	Perf 12/2980-84	
	wtr & 12 gals oil	
	Plug back 2973	
	Perf 28/2967-72	had slight show oil
	Plug back 2905	
	Perf 83/2916-30	Lans 2899'
	PP 24 BOPD	Reagan 3139'
	Br Lime 2878'	COMPLETED

Map No. _____ Sec. 36 Twp. 14 R. 14W

Well No. 5 Keil _____

_____ Texas _____ Company

_____ Powell & Peters _____ Contractor

NW SE SE


FIRST REPORT
SECTION PLAT

_____ Ft. from N. Line

990 _____ Ft. from S. Line

990 _____ Ft. from E. Line

_____ Ft. from W. Line

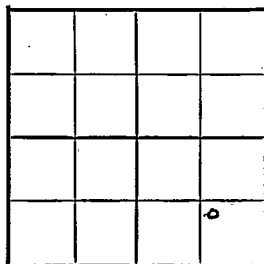

Russell County

Location _____

Rig up _____

Drilling and Remarks:

10" @ 706

drlg. 1770

RECORD

Cased _____ in., _____ ft.

Sand _____

Gas _____

Oil _____

Total Depth _____

PRODUCTION

1st 24 hrs. Nat. _____

1st 24 hrs. after shot _____

Gas _____ Cu. Ft.

Dry Hole _____

Abandoned _____

Date

NOV 23 1949 19

S. J. LEWIS

Scout

Scout Cards _____
Land Small Map _____
Land Wall Map _____
Tracings _____
France Map _____
Pierce Map _____
Misc. _____

NOV 25 1949

Kansas

Map No. _____ Sec. 36 Twp. 14 R. 14W

Well No. 5 Keil

Texas

Company _____

Contractor _____

NW SE SE


Elev. 1733
SECTION PLAT

_____ Ft. from N. Line

990 _____ Ft. from S. Line

990 _____ Ft. from E. Line

_____ Ft. from W. Line

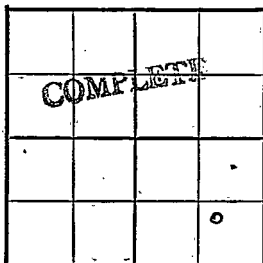

Russell County

Location _____

Rig up _____

Drilling and Remarks:

10" @ 706

7' @ 3142

T.D. 3166 tested
water. Plugback
to 3052 No Show
Plugback to 3070

RECORD

Cased _____ in., _____ ft.

Sand _____

Gas _____

Oil _____

Total Depth 3166

PRODUCTION

1st 24 hrs. Nat. _____

1st 24 hrs. after shot _____

Gas _____ Cu. Ft.

Dry Hole _____

Abandoned _____

Date

JAN 18 1950

19

J. E. TYRA

Scout

perf 17/3060-64 } no show
33/2996-3004 }

Plug back to 2987

perf - 4/2980-86 show
of oil and water.

perf - 12/2980-84 water
and 12 gals oil

Plug back 2973

perf 28/2967-72
had slight show oil

Plug back 2905

Perf - 83/2916-30

PP- 224 B.O.P.

Scott Cards
Land Small Map
Land Wall Map
Tracings
France Map
Pierce Map
Misc.

APR 20 1959