
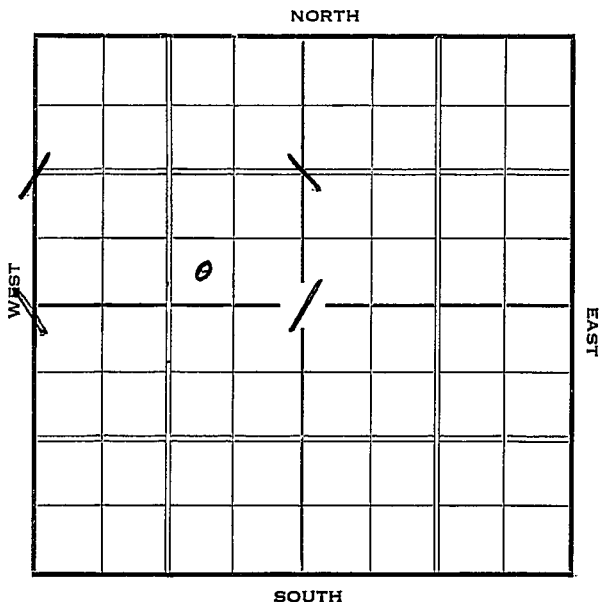


Section 36 Township 14 Range 14-WWell Number 1 - MichelCompany Phillips

Sec. 36 Twp. 14 R. 14-WWell No. #1 Michel FarmPhillips Company       Ft. from N. Line330 Ft. from S. Line990 Ft. from E. Line       Ft. from W. Line

Elev. 1756

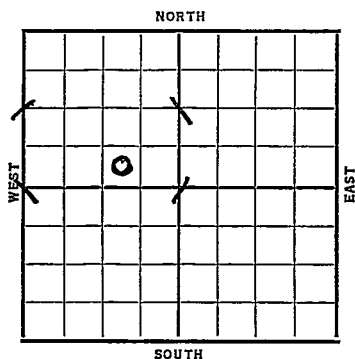

| Date | REPORT                       |
|------|------------------------------|
| 1937 |                              |
| 7/14 | Location                     |
| 7/23 | B. R.                        |
| 7/30 | S. H.                        |
| 8/6  | 10" @ 494'. WOC.             |
| 8/13 | Drlg. 2475'.                 |
| 8/20 | K.C. 2891'. T.D. 2915'.      |
|      | 7" @ 2913'. RUST.            |
| 8/28 | " " "                        |
| 9/3  | T.D. 2945'. 600' oil.        |
|      | Swab 4 BOPH Nat. 2000 acid.  |
|      | Swab 12 BOPH 6 hrs.          |
| 9/20 | Pot. 268 bbls. Will retreat. |
| 9/15 | 7" @ 2913'                   |
|      | KC 2891'                     |
|      | TD 2945'                     |
|      | 2000 acid                    |
|      | Pot 268                      |
|      |                              |
|      | COMPLETED                    |

KANSAS

Russell

Map No. \_\_\_\_\_ Sec. 36 Twp. 14 R. 14 WWell No. 1-MichelPhillips Company

Contractor

## FIRST REPORT

\_\_\_\_\_ Ft. from N. Line

330 Ft. from S. Line990 Ft. from E. Line

\_\_\_\_\_ Ft. from W. Line

## SECTION PLAT

|   |   |   |  |
|---|---|---|--|
|   |   |   |  |
| / |   | / |  |
| / | 0 | / |  |
|   |   |   |  |
|   |   |   |  |

Location ✓

Rig up \_\_\_\_\_

Drilling and Remarks:

## RECORD

Cased \_\_\_\_\_ in., \_\_\_\_\_ ft.

Sand \_\_\_\_\_

Gas \_\_\_\_\_

Oil \_\_\_\_\_

Total Depth \_\_\_\_\_

## PRODUCTION

1st 24 hrs. Nat. \_\_\_\_\_

1st 24 hrs. after shot \_\_\_\_\_

Gas \_\_\_\_\_ Cu. Ft.

Dry Hole \_\_\_\_\_

Abandoned \_\_\_\_\_

Date

JUL 14 1937 19

H. D. Hatfield

Scout.

Russell KANSAS

Map No. \_\_\_\_\_ Sec. 36 Twp. 14 R. 14WWell No. 1- MichelPhillips Company

Contractor \_\_\_\_\_

**COMPLETED**

## SECTION PLAT

|  |   |  |  |
|--|---|--|--|
|  |   |  |  |
|  |   |  |  |
|  | 0 |  |  |
|  | 1 |  |  |
|  |   |  |  |

\_\_\_\_\_ Ft. from N. Line

330 Ft. from S. Line990 Ft. from E. Line

\_\_\_\_\_ Ft. from W. Line

Location \_\_\_\_\_

Rig up \_\_\_\_\_

Drilling and Remarks:

2000 and  
pot 268

## RECORD

Cased 7 in., 2913 ft.Sand KC 2891

Gas \_\_\_\_\_

Oil \_\_\_\_\_

Total Depth 2945

## . PRODUCTION

1st 24 hrs. Nat. \_\_\_\_\_

1st 24 hrs. after shot \_\_\_\_\_

Gas \_\_\_\_\_ Cu. Ft.

Dry Hole \_\_\_\_\_

Abandoned \_\_\_\_\_

Date

SEP 15 1937<sub>19</sub>H. D. Hatfield Scout