

County **Saline** State **Kansas**
 Sec. **11** (Bk. **14** (Sur. **4W** Map No.
 (Twp.) (Rge.)
 Operator **C. U. Bay & Shields**
 Well No. **1** Farm **Johnson**
 Elev. Location **NE NE SE**
 330 Ft. From **N** Line **SE**
 330 Ft. From **E** Line Quarter
 1st. Report **JUL 28 1954**
 Completion
 Remarks
 Spudding Date
 Drlg. Data **Wildcat**

Cellar & pits

J. G. McGEHEE

County **Saline** State **Kansas**
 Sec. **11** (Bk. **14** (Sur. **4W** Map No.
 (Twp.) (Rge.)
 Operator **C. U. Bay & Shields**
 Well No. **1** Farm **Johnson**
 Elev. **1252** Location **NE NE SE**
 330 Ft. From **N** Line **SE**
 330 Ft. From **E** Line Quarter
 1st. Report
 Completion **SEP 1 1954**
 Remarks **Wildcat**
 Spudding Date **8-8-54**
 Drlg. Data **D & A TD 3805**

8 5/8" @ 371 Anhy 364 Heeh. 2076
 Tor. 2096 Doug. 2119 Br. line 2228
 Lans. 2281 Miss. 2965 Kh. 3288
 Misener 3401 Hunton 3403 Syl. sh. 3487
 Maq. dol. 3598 Viola 3637 Simp. 3698
 DST 3750-65 failed DST 3757-65
 open 1 hr. Rec. 30' mud & wtr. 60' sw
 1200# Arb. 3789 TD 3805
 D & A

FABE

Saline KANSAS


SEC.	11	TWP.	14	R.	4W
WELL NO.	1 Johnson				
COMPANY	C. U. Bay & Shields				
CONTRACTOR	Wildcat				

330 Ft. from N. Line

Ft. from S. Line

330 Ft. from E. Line

Ft. from W. Line

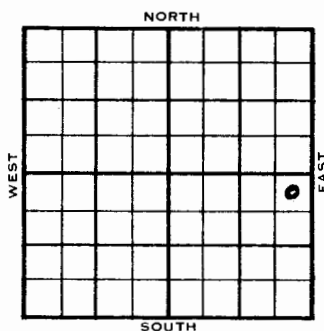

NE NE SE

	ELEVATION	REPORT
1954	1252'	

7/28 Callar & Pits

9/1 Spud 8-8-54 D & A TD 3805
 8-5/8" @ 371 Anhy 364 Heeb 2076
 Tor. 2096 Doug. 2119 Br lime 2228
 Lans. 2281 Miss 2965 Kh. 3288
 Misener 3401 Hunton 3403 Syl. sh.
 3487' Maq. dol. 3598 Viola 3637
 Simp. 3698
 DST 3750-65, failed.
 DST 3757-65 open 1 hr rec 30' mud &
 wtr. 60' SW 1200# Arb. 3789
 TD 3805' D & A

ABANDONED

Saline KANSAS

DX 78-1

Section	11	Township	14	Range	4W
Well No.	1 Johnson				
Company	C. U. Bay & Shields				

