


Section 4 Township 14 Range 15-W


Well Number #18 W E Benso

Company Stanolind

NORTH

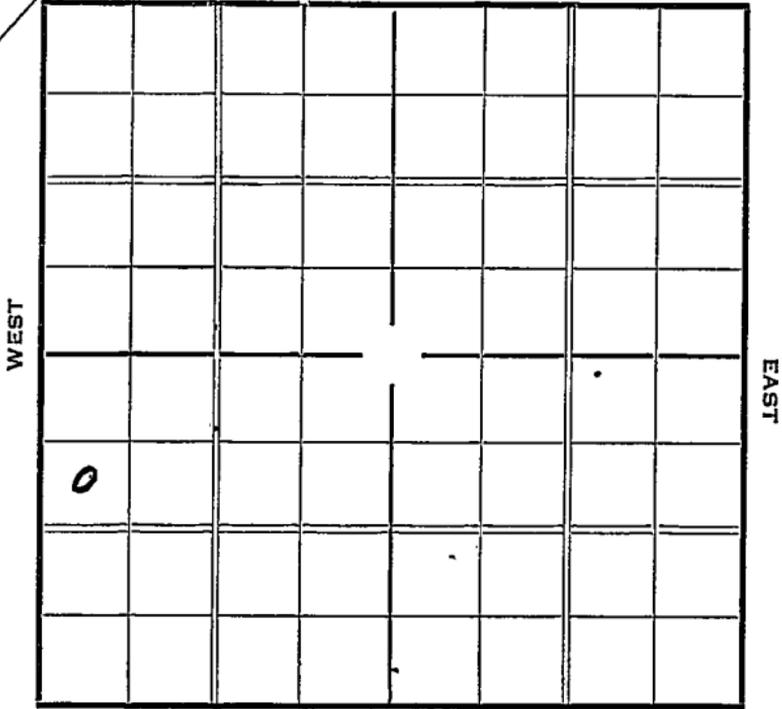

SOUTH

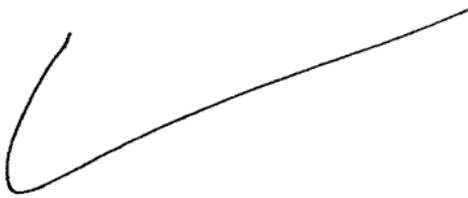

Sec. 4 Twp. 14 R. 15-W

Well No. #18 W E Benso Farm

Stanolind Company


990 Ft. from N. Line

_____ Ft. from S. Line

_____ Ft. from E. Line

330 Ft. from W. Line

Elev. 1889

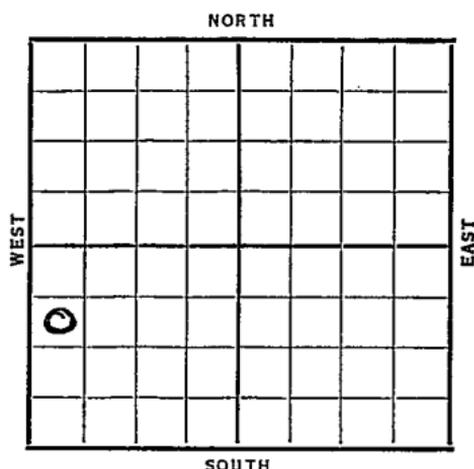

Date	REPORT
1937	
10/13	BCR
10/22	13" @ 564'. Drlg. 860'.
10/29	Anhy 915'. 10" @ 920'.
	Drlg. 1990'.
11/5	8" @ 2425'. Drlg. 2460'.
11/12	K.C. 3040'. 7" @ 3045'.
	Pay 3073-78' T.D. Swab 1 bbl.
	oil per hr.
11/19	" "
11/23	7" @ 3045'.
	K.C. 3040'.
	T.D. 3078'.
	1000 acid.
	Potential 336 oil & 20 water.
	COMPLETED

Russell **KANSAS**

Map No. _____ Sec. 4 Twp. 14 R. 15W

Well No. 18 W E Benso

Stanolind Company

FIRST REPORT Contractor

SECTION PLAT

990 SW NW SW
Ft. from N. Line

_____ Ft. from S. Line

_____ Ft. from E. Line

330 Ft. from W. Line

0			

Location _____

Rig up _____

Drilling and Remarks:
BCR

RECORD

Cased _____ in., _____ ft.

Sand _____

Gas _____

Oil _____

Total Depth _____

PRODUCTION

1st 24 hrs. Nat. _____

1st 24 hrs. after shot _____

Gas _____ Cu. Ft.

Dry Hole _____

Abandoned _____

Date

OCT 13 1937

H. D. Hatfield Scout

Russell **KANSAS**

Map No. 72 Sec. 4 Twp. 14 R. 15W

Well No. 18 W. E. Benso

Stanolind

Company

Contractor

COMPLETE

SW NW SW

990 Ft. from N. Line

_____ Ft. from S. Line

_____ Ft. from E. Line

330 Ft. from W. Line

SECTION PLAT

0			

Location _____

Rig up _____

Drilling and Remarks:

1000 acid

POT- 336 oil

20 water

RECORD

Cased 7 in., 3045 ft.

Sand KC 3040

Gas _____

Oil _____

Total Depth 3078

PRODUCTION

1st 24 hrs. Nat. _____

1st 24 hrs. after shot _____

Gas _____ Cu. Ft.

Dry Hole _____

Abandoned _____

Date

NOV 23 1937 19

H. D. Hatfield Scout