


Section 4 Township 14 Range 15-W

Well Number #19 W.E. Benso

Company Stanolind

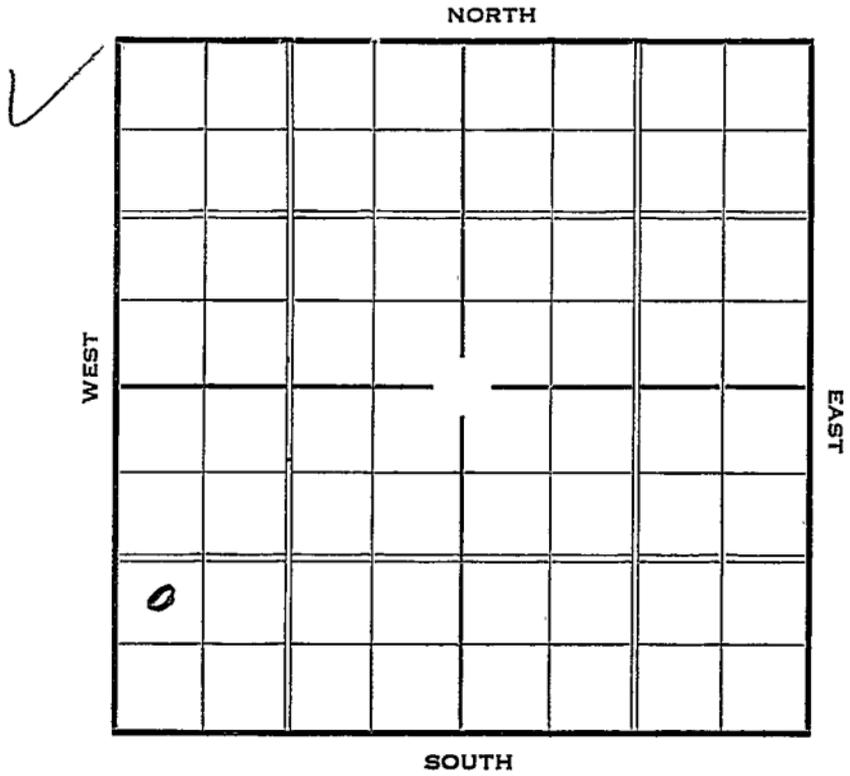

Sec. 4 Twp. 14 R. 15-W

Well No. #19 W E Benso Farm

Stanolind Company


_____ Ft. from N. Line

990 Ft. from S. Line

_____ Ft. from E. Line

330 Ft. from W. Line

Elev. 1886

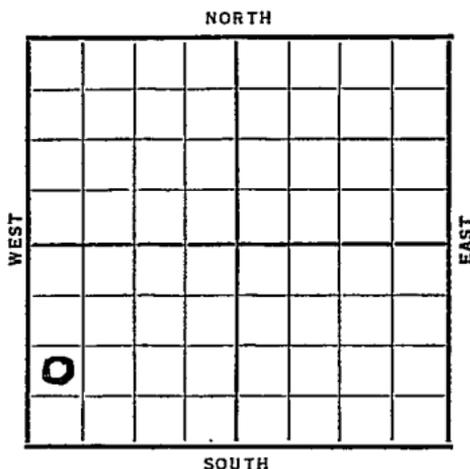

Date	REPORT
1937	
10/13	Cellar
10/22	Mat.
10/29	R. U.
11/5	15" @ 41'. Rng. 12" @ 558'.
11/12	Anhy 920'. Drlg. 1695'.
11/19	8" @ 2480'. T.D. 2512'. C.O.
11/26	8" @ 2512'. 6" @ 3052'.
	K.C. 3045'. S.O. 3070-74'.
	1 1/2 BW. T.D. 3085'. C.O.
12/3	S.O. 3078-80'. 6" @ 3099'.
	Drlg. 3275'.
12/10	T.D. 3407', no oil.
	Shut down. orders.
	OVER

1937

12/15 6" @ 3099'.

Gorham 3265'.

Granite wash 3275'.

Granite 3403'.

T.D. 3407'.

ABANDONED

Map No. _____ Sec. 4 Twp. 14 R. 15WWell No. 19 W E BensoStanolind Company

Contractor

FIRST REPORT**SECTION PLAT**

NW SW SW

_____ Ft. from N. Line

990 Ft. from S. Line

_____ Ft. from E. Line

330 Ft. from W. Line

0			

Location _____

Rig up _____

Drilling and Remarks:

Cellar

NA

RECORD

Cased _____ in., _____ ft.

Sand _____

Gas _____

Oil _____

Total Depth _____

PRODUCTION

1st 24 hrs. Nat. _____

1st 24 hrs. after shot _____

Gas _____ Cu. Ft.

Dry Hole? _____

Abandoned _____

Date

OCT 13 1937 19 H. D. Hatfield Scout

