


Russell

Map No. Sec. 4 Twp. 14 R. 15W

Well No. 2-11 Portland Farm
Central Pet. Company

 Ft. from N. Line
330 Ft. from S. Line
330 Ft. from E. Line
 Ft. from W. Line

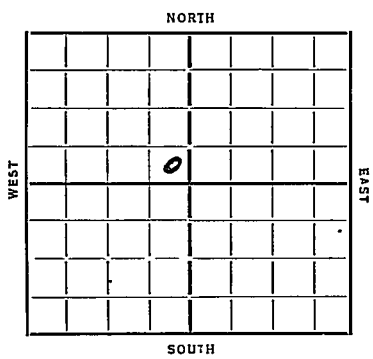

Date 7/3/5

REPORT

3/6 Bldg.
3/14 Rgn
3/21 Dlg 275
3/28 15" 603 Aubey 895 Dlg 1245
4/4 Dlg 2070
4/11 " 2685 8" 2668
4/18 S.O. 2759-55 8" 2763
Oswald 3023 Oil 3041
Dlg 3056
4/26
5/1 Oswald 3023 T-1 3061
1600 acid 988 Bldg.

COMPLETED

Map No. 77 Sec. 4 Twp. 14 R. 15W

Well No. 20-Portland

Central Pet Company

Contractor

FIRST REPORTS

SECTION PLAT

.....Ft. from N. Line

330 Ft. from S. Line

330 Ft. from E. Line

.....Ft. from W. Line

	0		

Location.....

Rig up.....

Drilling and Remarks:

Bed

RECORD

Cased..... in.,ft.

Sand.....

Gas.....

Oil.....

Total Depth.....

PRODUCTION

1st 24 hrs. Nat.....

1st 24 hrs. after shot.....

Gas..... Cu. Ft.

Dry Hole.....

Abandoned.....

Date

3-6-35

192

ORVAL MANNSCHRECK

Scout

Form 26-1M Bks. 9-23
Russell


Map No. *72* Sec. *4* Twp. *14* R. *15W*

Well No. *20-Portland*
Central pet Company

Contractor

COMPLETED

SECTION PLAT

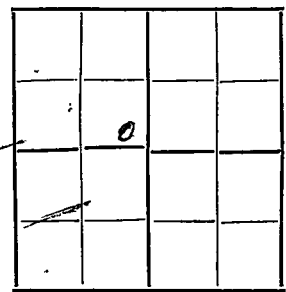

..... Ft. from N. Line

330 Ft. from S. Line

330 Ft. from E. Line

..... Ft. from W. Line

Location.....

Rig up.....

Drilling and Remarks:

1000 acid

988 lbs

RECORD

Cased..... in., ft.

Sand *Orwald 3023*

Gas.....

Oil.....

Total Depth *3061*

PRODUCTION

1st 24 hrs. Nat.....

1st 24 hrs. after shot.....

Gas..... Cu. Ft.

Dry Hole.....

Abandoned.....

Date

5-1-35 192.....

ORVAL MANNSCHRECK

Scout