


Russell

Form 51-5M-5-34-Palace

Map No. **KANSAS** Sec. **4** Twp. **14** R. **15W**

Well No. **4-Mills** Farm \_\_\_\_\_  
**Alpena et al** Company \_\_\_\_\_

NORTH

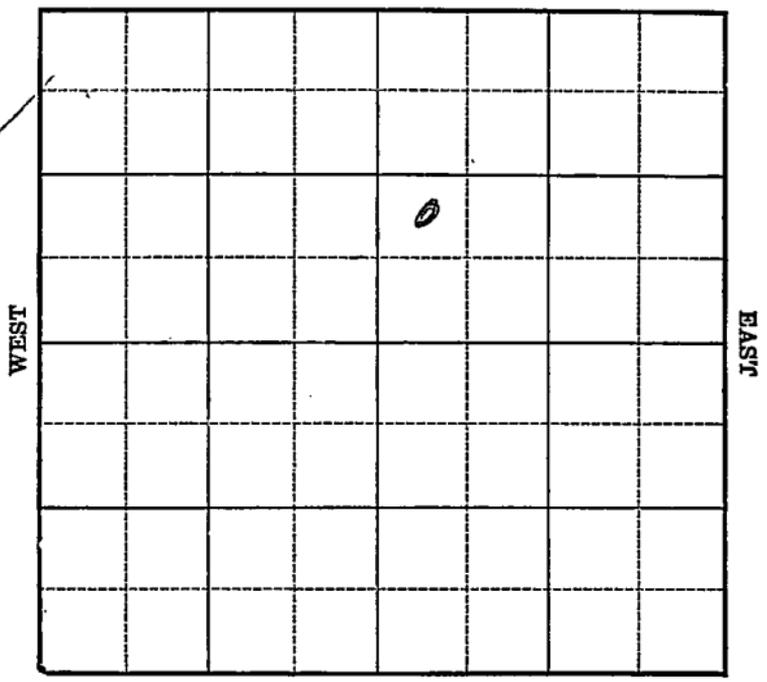

SOUTH

Location \_\_\_\_\_

Drilling Remarks \_\_\_\_\_

\_\_\_\_\_

\_\_\_\_\_

**RECORD**

Cased \_\_\_\_\_ in. \_\_\_\_\_ ft.

Sand \_\_\_\_\_

Gas \_\_\_\_\_

Oil \_\_\_\_\_

Total Depth \_\_\_\_\_

Rig Up \_\_\_\_\_

Drilling Remarks \_\_\_\_\_

\_\_\_\_\_

\_\_\_\_\_

**PRODUCTION**

1st 24 hrs. Nat. \_\_\_\_\_

1st 24 hrs. after shot \_\_\_\_\_

Gas \_\_\_\_\_ cu. ft. \_\_\_\_\_

Dry Hole \_\_\_\_\_


Abandoned \_\_\_\_\_

Russell

Map No. KANSAS Sec. 4 Twp. 14 R. 15W

Well No. 4-Milly Farm  
Alyward et al Company

\_\_\_\_\_ Ft. from N. Line  
990 Ft. from S. Line  
\_\_\_\_\_ Ft. from E. Line  
990 Ft. from W. Line

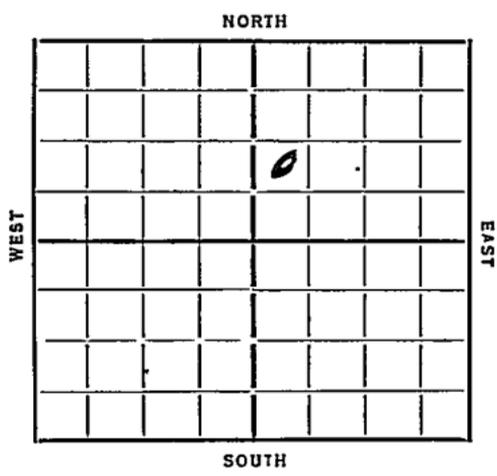

Date 1935

REPORT

4/24 Rgn  
5/2 Dlg 785 15" 405  
5/9 " 2015 12" 610 10" 905  
5/16 8" 2500 s.o. 2745  
Dly 2820  
5/23 " 2940 8" 2750  
5/29 \_\_\_\_\_  
6/5 Overall 3015 T 2 3075  
2000 acid  
350 Bbls.

COMPLETED

Map No. 72 Sec. 4 Twp. 14 R. 15W

Well No. 4 - Mills

Alward et al Company

Contractor

**FIRST REPORT**

**SECTION PLAT**

		a	.
			i

..... Ft. from N. Line

990 Ft. from S. Line

..... Ft. from E. Line

330 Ft. from W. Line

Location.....

Rig up.....

Drilling and Remarks:

Regn

**RECORD**

Cased..... in., ..... ft.

Sand.....

Gas.....

Oil.....

Total Depth.....

**PRODUCTION**

1st 24 hrs. Nat.....

1st 24 hrs. after shot.....

Gas..... Cu. Ft.

Dry Hole.....

Abandoned.....

Date

4-27-35

**ORVAL MANSCHRECK** Scout

Map No. 72 Sec. 4 Twp. 14 R. 15W

Well No. 4-Mills

Olyward et al Company

Contractor

COMPLETED

SECTION PLAT

		O	

Ft. from N. Line

990 Ft. from S. Line

Ft. from E. Line

330 Ft. from W. Line

RECORD

Location

Rig up

Drilling and Remarks:

2000 and

350 fbs

Cased \_\_\_\_\_ in. \_\_\_\_\_ ft.

Sand Oswald 3015

Gas \_\_\_\_\_

Oil \_\_\_\_\_

Total Depth 3075

PRODUCTION

1st 24 hrs. Nat. \_\_\_\_\_

1st 24 hrs. after shot \_\_\_\_\_

Gas \_\_\_\_\_ Cu. Ft.

Dry Hole \_\_\_\_\_

Abandoned \_\_\_\_\_

Date

6-5-35 192

RECORDS

Scout