
KANSAS Russell

Form 51—5M—3-35—Mid-West

Map No. ____ Sec. 4 Twp. 14 R. 15-W

Well No. #3 Dortland "B" Farm

Central Pet. Company

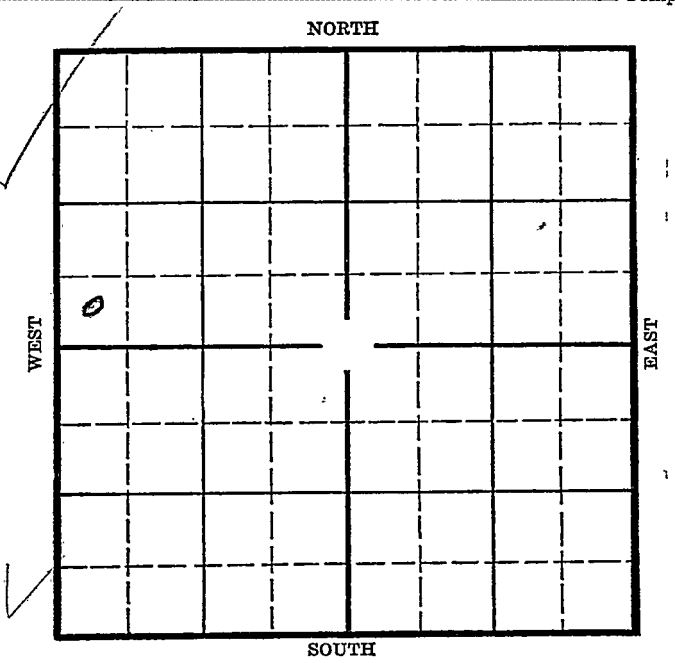


Location

Drilling Remarks

Rig Up

Drilling Remarks

RECORD

Cased ____ in. ____ ft.

Sand

Gas

Oil

Total Depth

PRODUCTION

1st 24 hrs. Nat.

1st 24 hrs. after shot

Gas ____ cu. ft.

Dry Hole

Abandoned

KANSAS
Form 252-A—5M—7-36—Palace

Russell

Sec. 4 Twp. 14 R. 15-W

Well No. #3 Dortland "B" Farm


Central Pet. Company

____ Ft. from N. Line

330 Ft. from S. Line

____ Ft. from E. Line

330 Ft. from W. Line

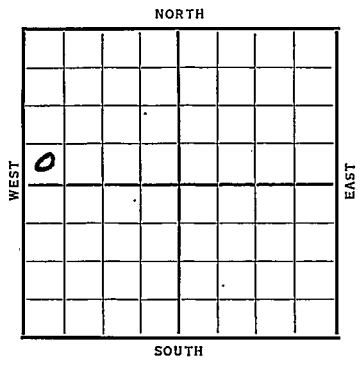


Elev. 1896

| Date 1936 | REPORT |
|---|---|
| 9/16 | Rigging up |
| 9/24 | --Anhydrate 942'. Set 10" @ 942'. |
| 10/1 | Drlg. 2290'. |
| 10/8 | 8" @ 2530'. Drlg. 2678'. |
| 10/15 | Drlg. 3050'. |
| | |
| 10/21/36 | -Lansing 3069'. |
| | T.D. 3079'. |
| | 5000 gallons of acid. |
| | 560 oil and 40 water. |
| | |
| | COMPLETED |

Form 26—1M Blks 12-29 KANSAS


Map No. 72 Sec. 4 Twp. 14 R. 15W.

Well No. 3 Dorland "B"

Central Pet. Company

Contractor

SECTION PLAT

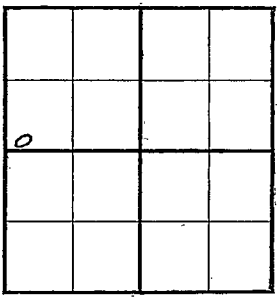

____ Ft. from N. Line

330 Ft. from S. Line

____ Ft. from E. Line

330 Ft. from W. Line

FIRST REPORT

Location ____

Rig up ____

Drilling and Remarks:

Rigging up

RECORD

Cased ____ in., ____ ft.

Sand ____

Gas ____

Oil ____

Total Depth ____

PRODUCTION

1st 24 hrs. Nat. ____

1st 24 hrs. after shot ____

Gas ____ Cu. Ft.

Dry Hole ____

Abandoned ____

Date

SEP 16 1936 19____ S. J. LEWIS Scout

Form 26—1M Bks.—2-29

KANSAS

Russell


Map No. 72 Sec. 4 Twp. 14 R. 15W

Well No. 3 Dortland "B"

Central Pet. Company

Contractor

SECTION PLAT

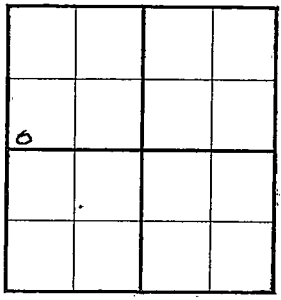


____ Ft. from N. Line

330 Ft. from S. Line

____ Ft. from E. Line

330 Ft. from W. Line

COMPLETED

Location ____

Rig up ____

Drilling and Remarks:

Lansing 3069

500 Sand

560 oil

40 water

RECORD

Cased ____ in., ____ ft.

Sand ____

Gas ____

Oil ____

Total Depth 3079

PRODUCTION

1st 24 hrs. Nat. ____

1st 24 hrs. after shot ____

Gas ____ Cu. Ft.

Dry Hole ____

Abandoned ____

Date

OCT 21 1936

19

S. J. LEWIS Scout