

KANSAS

Form 51-5M-7-40-Palace

Russell

Section 4 Township 14 Range 15-W

Well No. #1 Miles "A"

Company Bridgeport

NORTH Gorham Pool

							0		


SOUTH

Sec. 4 Twp. 14 R. 15-WWell No. #1 Miles "A" FarmBridgeport Company

(Gorham)

990 Ft. from N. Line Ft. from S. Line660 Ft. from E. Line Ft. from W. Line

Elev. 1896

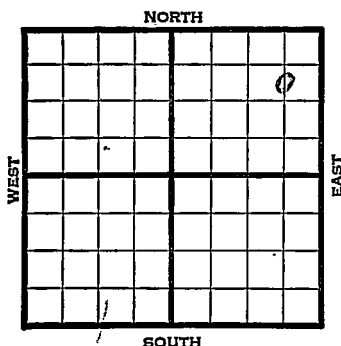

1940	REPORT			
12/11	8" - 656' WOC.			
12/19	Anhy 927' Drlg. 2450'			
12/26	No report.			
1941				
1/2	Drlg. 3090'			
1/9	No report.			
1/16	Lans. 3040' 5" - 3071'			
	T.D. 3090' 7000 acid.			
	Swab 6 bbls. per hour 6 hours.			
1/23	"	"	"	"
1/30	"	"	"	"
2/6	"	"	"	"
2/13	"	"	"	"
2/20	"	"	"	"
2/27	"	"	"	"
	OVER			

1941

3//5

Lans. 3040'

5" - 3071'

T.D. 3090'

7000 acid.

Potential 63 bbls., pump.

36.5 Gravity

COMPLETED

Map No. 72 Sec. 4 Twp. 14 R. 15WWell No. 1 Miles "A"

Bridgeport

Company

FIRST REPORT

Contractor

C S L NE NE

990 Ft. from N. Line Ft. from S. Line660 Ft. from E. Line Ft. from W. Line

GORHAM POOL

SECTION PLAT

			o

Location Rig up

Drilling and Remarks:

8" - 656 WOC

RECORDCased in., ft.Sand Gas Oil Total Depth **PRODUCTION**1st 24 hrs. Nat. 1st 24 hrs. after shot Gas Cu. Ft.Dry Hole Abandoned

Date

DEC 11 1940 19S. J. LEWIS

Scout

Misc. Small Maps	
Cards	
Tracing	
France Map	
Scarborough Map	
Moody Map	
Geological Dept.	
Moody Flat Book	

Map No. 72 Sec. 4 Twp. 14 R. 15WWell No. 1 Miles "A"Bridgeport Machine CompanyContractor**COMPLETED**

C S L N E N E

990 Ft. from N. Line Ft. from S. Line660 Ft. from E. Line Ft. from W. Line**SECTION PLAT**

			o

GORHAM POOL

Location Rig up

Drilling and Remarks:

*Lane 3040**5-103071**7000 acid**Pump 63 P.S.**36.5 Gr.***RECORD**Cased in., ft.Sand Gas Oil Total Depth 3090**PRODUCTION**1st 24 hrs. Nat. 1st 24 hrs. after shot Gas Cu. Ft.Dry Hole Abandoned

Date

MAR 5 1941 19

S. J. LEWIS

Scout

Misc. Small Maps

Cards

Tracing

Franklin Map

Scarborough Map

Moody Map

Geological Dept.

Moody Flat Book