


Russell

Form 51-5M-5-34-Palace

Map No. KANSAS Sec. 4 Twp. 14 R. 15W

Well No. 1 Mills Farm
Alward et al Company

NORTH

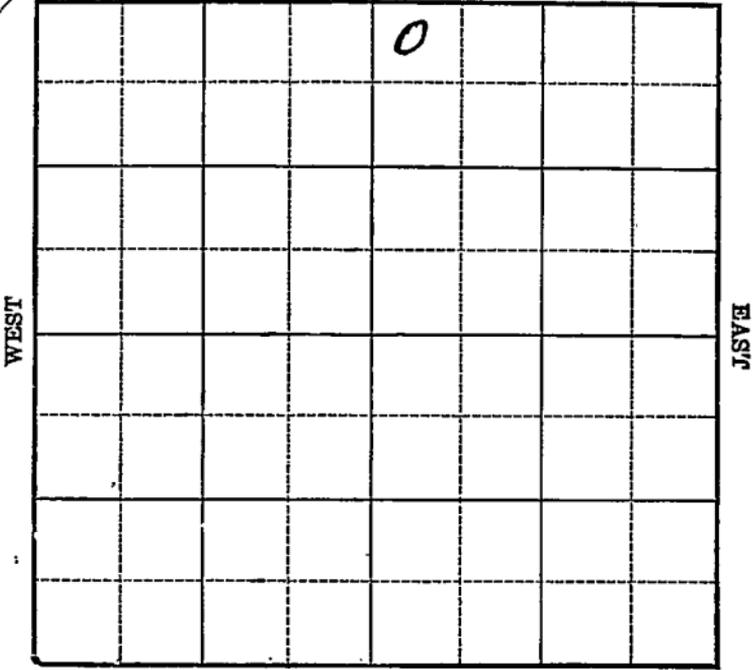

SOUTH

Location _____

Drilling Remarks _____

Rig Up _____

Drilling Remarks _____

RECORD

Cased _____ in. _____ ft.

Sand _____

Gas _____

Oil _____

Total Depth _____

PRODUCTION

1/2 24 hrs. Nat. _____

24 hrs. after shot _____

_____ cu. ft.

Hole _____

andoned _____

Russell

Map No. KANSAS Sec. 4 Twp. 14 R. 15W


Well No. 1 Mills Farm
Alford et al Company

330 Ft. from N. Line

_____ Ft. from S. Line

_____ Ft. from E. Line

330 Ft. from W. Line

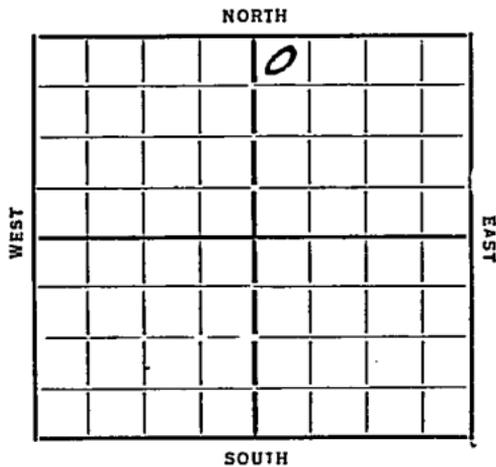

Date	REPORT
10/31	Location
11/8	Rig
11/15	Spud
11/22	15" 380 12" 620 Aug 925 10" 928 Dly 945
11/28	Dly 2120
12/6	" 2735 8" 2510
12/13	8" 2711 A.O.O. 2765 A.O.O. 2830-40 Dly 3020
12/21	T) 3090 1000 acid P 95 B 12 hrs.
12/27	Revald 3040 6" 3040 A.O. 3062 T) 3090 1000 acid 72 Bbls 74 hrs.
1/3/35	2000 Gal acid
1/9	Revald 3040 T) 3090 1000 acid 728 Bbls.

COMPLETED

Map No. 72 Sec. 4 Twp. 14 R. 15W

Well No. 1-Mills

Alward et al Company

Contractor

FIRST REPORTS


SECTION PLAT

330 Ft. from N. Line

_____ Ft. from S. Line

_____ Ft. from E. Line

330 Ft. from W. Line

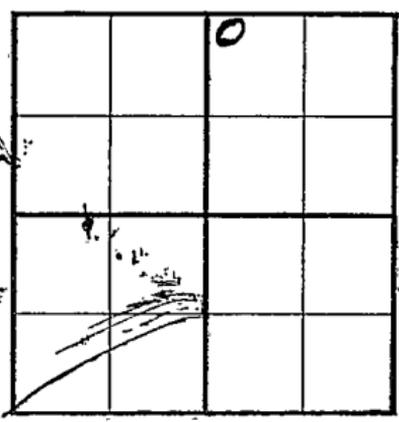

Location

Rig up _____

Drilling and Remarks:

RECORD

Cased _____ in., _____ ft.

Sand _____

Gas _____

Oil _____

Total Depth _____

PRODUCTION

1st 24 hrs. Nat. _____

1st 24 hrs. after shot _____

Gas _____ Cu. Ft.

Dry Hole _____

Abandoned _____

Date

10-31-34 19

ORVAL MANNSCHRECK

Scout

Map No. 72 Sec. 4 Twp. 14 R. 15W

Well No. 1-7 miles

Alyward et al Company

Contractor

SECTION PLAT

COMPLETED

330 Ft. from N. Line
..... Ft. from S. Line
..... Ft. from E. Line
330 Ft. from W. Line

		0	

Location.....

Rig up.....

Drilling and Remarks:

1000 acid

228 bbls

RECORD

Cased 1 in., ft.

Strat Dwale 3040

Gas.....

Oil.....

Total Depth 3090

PRODUCTION

1st 24 hrs. Nat.....

1st 24 hrs. after shot.....

Gas.....Cu. Ft.

Dry Hole.....

Abandoned.....

Date

1-9-35 192.....

ORVAL MANNSCHRECK

.....Scout