


Map No. **KANSAS** Sec. **4** Twp. **14** R. **15W**
Well No. **3-Mills** Farm
Bridgeport Company

Russell

NORTH

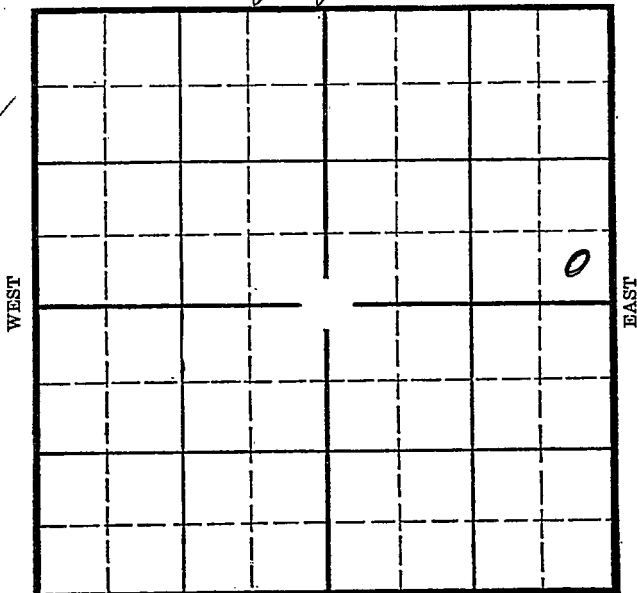

SOUTH

Location _____
Drilling Remarks _____

Rig Up _____
Drilling Remarks _____

RECORD

PRODUCTION

Cased _____ in. _____ ft.
 Sand _____
 Gas _____
 Oil _____
 Total Depth _____

1st 24 hrs. Nat. _____
 1st 24 hrs. after shot _____
 Gas _____ cu. ft. _____
 Dry Hole _____
 Abandoned _____

Russell
15^W

Map No. Sec. 4 Twp. 14 R.

Well No. 3- Mills Farm
Bridgeport Company


 Ft. from N. Line

330 Ft. from S. Line

330 Ft. from E. Line

 Ft. from W. Line

Elev. 1885

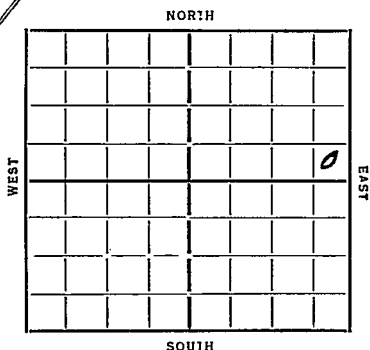

| Date | REPORT |
|-------|---------------------|
| 1935 | |
| 8/21 | Location |
| 8/29 | Ponds. |
| 9/6 | — |
| 10/3 | Dlg 2010 |
| 10/19 | " 2585 8" 2568 |
| 10/30 | Asvold 3045 |
| | T.D. 2117 |
| | 1000 acid |
| | 245 Oil |
| | |
| | |
COMPLETED

KANSAS

Map No. 72 Sec. 4 Twp. 14 R. 15W

Well No. 3-Mills

Bridgport Company

Contractor

FIRST REPORTS

..... Ft. from N. Line

330 Ft. from S. Line

330 Ft. from E. Line

..... Ft. from W. Line

SECTION PLAT

| | | | |
|--|--|--|---|
| | | | |
| | | | |
| | | | 0 |
| | | | |
| | | | |

Location ✓

Rig up

Drilling and Remarks:

RECORD

Cased.....in.,ft.

Sand.....

Gas.....

Oil.....

Total Depth.....

PRODUCTION

1st 24 hrs. Nat.....

1st 24 hrs. after shot.....

Gas..... Cu. Ft.

Dry Hole.....

Abandoned.....

Date

8-21-35 192

ORVAL MANNSCHRECK

Scout

Map No. 72 Sec. 4 Twp. 14 R. 15W

Well No. 3-Mills

Bridgport Company

Contractor

COMPLETED

SECTION PLAT

.....Ft. from N. Line

330 Ft. from S. Line

330 Ft. from E. Line

.....Ft. from W. Line

| | | | |
|--|--|--|---|
| | | | |
| | | | |
| | | | 0 |
| | | | |
| | | | |

Location.....

Rig up.....

Drilling and Remarks:

1000 acid

245 oil

RECORD

Cased.....in.,.....ft.

Sand swell 3045

Gas.....

Oil.....

Total Depth 3117

PRODUCTION

1st 24 hrs. Nat.....

1st 24 hrs. after shot.....

Gas.....Cu. Ft.

Dry Hole.....

Abandoned.....

Date

ROYAL MANN SCHRECK

10-30-35 192.....

Scout