


Russell

Map No. KANSAS Sec. 4 Twp. 14 R. 15^W

Well No. 3 Mills Farm
Alyward et al Company

_____ Ft. from N. Line
330 Ft. from S. Line
_____ Ft. from E. Line
330 Ft. from W. Line

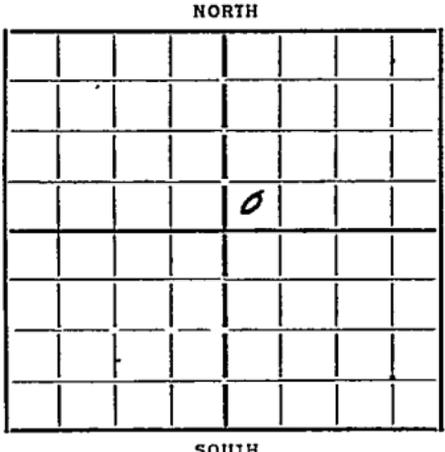

Elevation 1874

Date	REPORT
2/25	
2/27	Bldg. Rig
3/7	Spill
3/14	Blg 550 15" 257
3/21	" 2185 10" 915
3/28	8" 2205 2490 WR 8"
4/4	Orwell 3025 6" 3095
4/11	T 7 3085 2000' oil 1500 acid
4/17	Orwell 3025 T 7 3085 1500 acid 949 Bbls.

COMPLETED

Russell

Map No. 72 Sec. 4 Twp. 14 R. 15^W

Well No. 3-Mills

Alywardal Company

Contractor

SECTION PLAT

FIRST REPORTS

Ft. from N. Line

330 Ft. from S. Line

Ft. from E. Line

330 Ft. from W. Line

		0	

Location.....

Rig up.....

Drilling and Remarks:

Bedg Rig

RECORD

Cased.....in.,ft.

Sand.....

Gas.....

Oil.....

Total Depth.....

PRODUCTION

1st 24 hrs. Nat.....

1st 24 hrs. after shot.....

Gas.....Cu. Ft.

Dry Hole.....

Abandoned.....

Date

2-27-35 192

ORVAL MANNSCHRECK
Scout

Russell

Map No. 72 Sec. 4 Twp. 14 R. 15W

Well No. 3-miles

Alward et al Company

Contractor

COMPLETED

SECTION PLAT

		0	

..... Ft. from N. Line

330 Ft. from S. Line

..... Ft. from E. Line

330 Ft. from W. Line

Location.....

Rig up.....

Drilling and Remarks:

1500 and

949 lbs

RECORD

Cased..... in., ft.

Sand Orval 3025

Gas.....

Oil.....

Total Depth 3085

PRODUCTION

1st 24 hrs. Nat.....

1st 24 hrs. after shot.....

Gas..... Cu. Ft.

Dry Hole.....

Abandoned.....

Date

4-17-35 192

ORVAL MANNSCHE Scout