


Russell

Form 51-5M-5-34-Palace

Map No. **KANSAS** Sec. **4** Twp. **14** R. **15W**

Well No. **F-B Witt** Farm  
**Billings stal** Company

NORTH

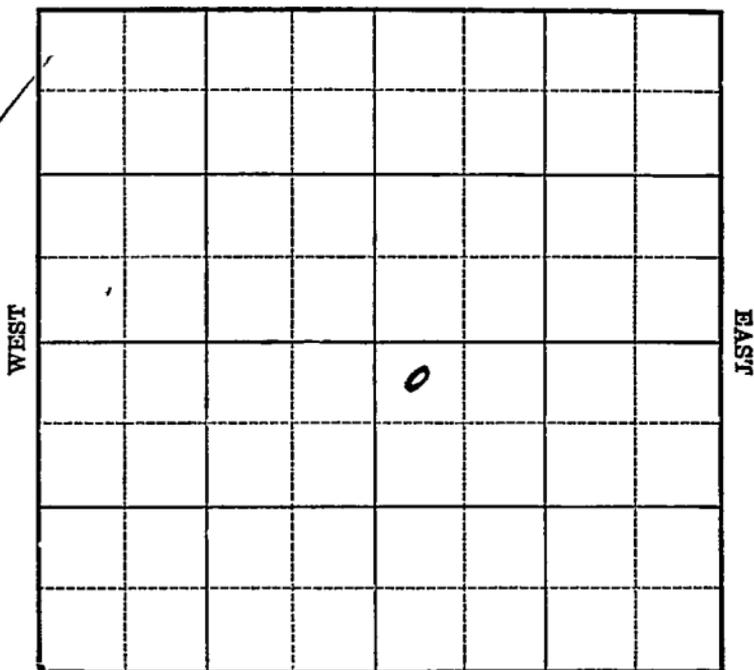

SOUTH

Location \_\_\_\_\_

Drilling Remarks \_\_\_\_\_

\_\_\_\_\_

\_\_\_\_\_

**RECORD**

Cased \_\_\_\_\_ in. \_\_\_\_\_ ft.

Sand \_\_\_\_\_

Gas \_\_\_\_\_

Oil \_\_\_\_\_

Total Depth \_\_\_\_\_

Rig Up \_\_\_\_\_

Drilling Remarks \_\_\_\_\_

\_\_\_\_\_

\_\_\_\_\_

**PRODUCTION**

1st 24 hrs. Nat. \_\_\_\_\_

1st 24 hrs. after shot \_\_\_\_\_

Gas \_\_\_\_\_ cu. ft. \_\_\_\_\_

Dry Hole \_\_\_\_\_

Abandoned \_\_\_\_\_

Russell

Map No. A GAS Sec. 4 Twp. 14 R. 15<sup>w</sup>


Well No. 1-B Witt Farm \_\_\_\_\_  
Billings et al Company \_\_\_\_\_

330 Ft. from N. Line

\_\_\_\_\_ Ft. from S. Line

\_\_\_\_\_ Ft. from E. Line

330 Ft. from W. Line

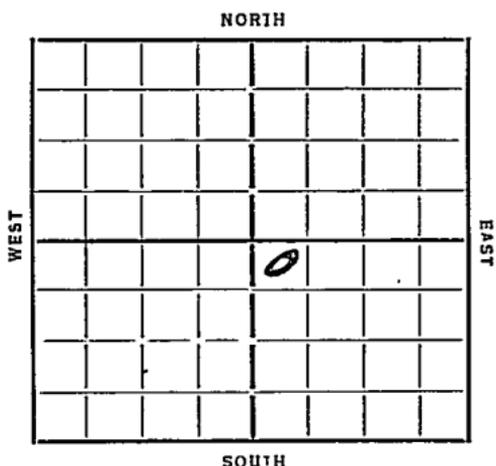

Date	REPORT
12/19	Location
12/27	Ponds
1/3/25	— 1/10 — 1/17 — 1/24 —
1/31	— 2/7 — 2/14 — 2/21 —
2/28	—
3/7	Rig
3/14	Rgn
3/21	Alg 219 20" 29
3/28	10" 594 CO.
4/4	Alg 1187
4/11	" 2160 10" 918
4/18	8" 2525
4/26	Alg 2720
5/2	Oswald 3012 S.O. 3032
	Alg 3048
5/8	Oswald 3012 T 7 3065
	1025 Bbls.

COMPLETED

KANSAS

Map No. 12 Sec. 4 Twp. 14 R. 15W

Well No. 1B-Witt

Billings et al Company

Contractor

FIRST REPORTS

SECTION PLAT

330 Ft. from N. Line

..... Ft. from S. Line

..... Ft. from E. Line

330 Ft. from W. Line

		0	

Location

Rig up .....

Drilling and Remarks:

RECORD

Cased..... in., ..... ft.

Sand.....

Gas.....

Oil.....

Total Depth.....

PRODUCTION

1st 24 hrs. Nat.....

1st 24 hrs. after shot.....

Gas..... Cu. Ft.

Dry Hole.....

Abandoned.....

Date

ORVAL MANNSCHRECK

12-19-34 192.....

Scout

Map No. 72 Sec. 4 Twp. 14 R. 15W

Well No. 1B-Witt

Billings et al Company

Contractor

**COMPLETED**

330 Ft. from N. Line

..... Ft. from S. Line

..... Ft. from E. Line

330 Ft. from W. Line

SECTION PLAT

		0	

Location .....

Rig up .....

Drilling and Remarks:

1025 fms

RECORD

Cased ..... in., ..... ft.

Sand Quartz 3012

Gas .....

Oil .....

Total Depth 3065

PRODUCTION

1st 24 hrs. Nat. ....

1st 24 hrs. after shot. ....

Gas ..... Cu. Ft.

Dry Hole .....

Abandoned .....

Date

5-8-35 192

**ORVAL MANNSCHRECK**

Scout