



Map No. Kansas Sec. 4 Twp. 14 R. 15<sup>W</sup>


Well No. 2 Witt Farm  
Bellings et al Company

\_\_\_\_\_ Ft. from N. Line

330 Ft. from S. Line

\_\_\_\_\_ Ft. from E. Line

330 Ft. from W. Line

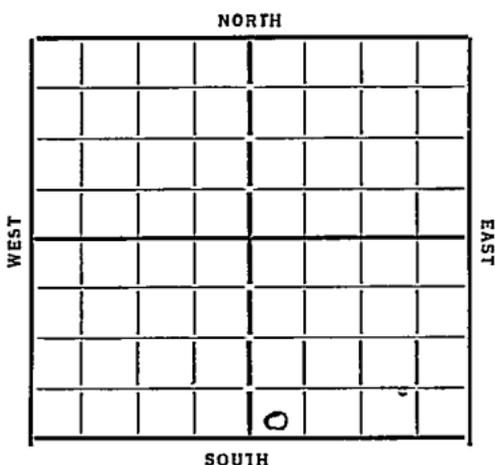

Date  
1933

REPORT

<u>5/24</u>	<u>location</u>
<u>6/1</u>	<u>—</u>
<u>6/18</u>	<u>—</u>
<u>6/15</u>	<u>Moving in</u>
<u>6/21</u>	<u>—</u>
<u>6/28</u>	<u>—</u>
<u>7/5</u>	<u>—</u>
<u>7/12</u>	<u>—</u>
<u>7/19</u>	<u>—</u>
<u>7/26</u>	<u>Bldg Rig</u>
<u>8/2</u>	<u>Rign up</u>
<u>8/9</u>	<u>—</u>
<u>8/16</u>	<u>—</u>
<u>8/23</u>	<u>— 12 1/2 - 520 dily 625'</u>
<u>8/30</u>	<u>10" - 891 L.D. 894</u>
<u>9/6</u>	<u>—</u>
<u>9/13</u>	<u>—</u>
<u>9/20</u>	<u>—</u>
<u>9/27</u>	<u>—</u>
<u>10/5</u>	<u>—</u>
<u>10/11</u>	<u>—</u>
<u>10/18</u>	<u>Reg 1050</u>
<u>10/25</u>	<u>" 1800</u>
<u>11/1</u>	<u>" 2229</u>
<u>11/8</u>	<u>Run 8" at 2480</u>

11/15 '33 Hrlg 2590

11/22 - 8" at 2740 - C.O.

11/29 S.D at 2940

12/6 T.D. 3009 - S.D for 6" CSG

12/13 Top Oswald 3019 - 6" 3019 show oil 3040 - 45 T.D.

12/27 T.D. 3080 - treated with 1000  
gal acid - no test

1/11 - Pay 3086-89 - treated  
with 1000 gal acid - no test

1934

1/17 - Oswald lime 3019

Pay 3086-89

1000 gallon acid

45 bbls Oil

Trace water

Russell

W

72 KANSAS Map No. Sec. 4 Twp. 14 R. 15

Well No. 2 Mitt

Billings G. et al. Company

Contractor

FIRST REPORTS

..... Ft. from N. Line

330 Ft. from S. Line

..... Ft. from E. Line

330 Ft. from W. Line

SECTION PLAT


Location..... ✓

Rig up.....

Drilling and Remarks:

RECORD

Cased..... in., ..... ft.

Sand.....

Gas.....

Oil.....

Total Depth.....

PRODUCTION

1st 24 hrs. Nat.....

1st 24 hrs. after shot.....

Gas..... Cu. Ft.

Dry Hole.....

Abandoned.....

Date

MAY 2 4 1933

192

CHAS. L. SHERWOOD

Scout

*Shirley  
no more*

Returned.....	
Cards.....	<i>AB</i>
Tracing.....	<i>CPH</i>
France Map.....	<i>X</i>
Scarborough Map.....	<i>X</i>
Moody Map.....	<i>X</i>
Scarborough Plat Book.....	
Moody Plat Book.....	



*no coal*

Returned	
Cards	<i>✓</i>
Tracing	<i>✓</i>
France Map	<i>✓</i>
Scarborough Map	<i>✓</i>
Moody Map	<i>✓</i>
Scarborough Flat Book	
Moody Flat Book	