


Russell

KANSAS

SECTION 4 TOWNSHIP 14S RANGE 15W

WELL NO. #1 Witt "D"

COMPANY CRA

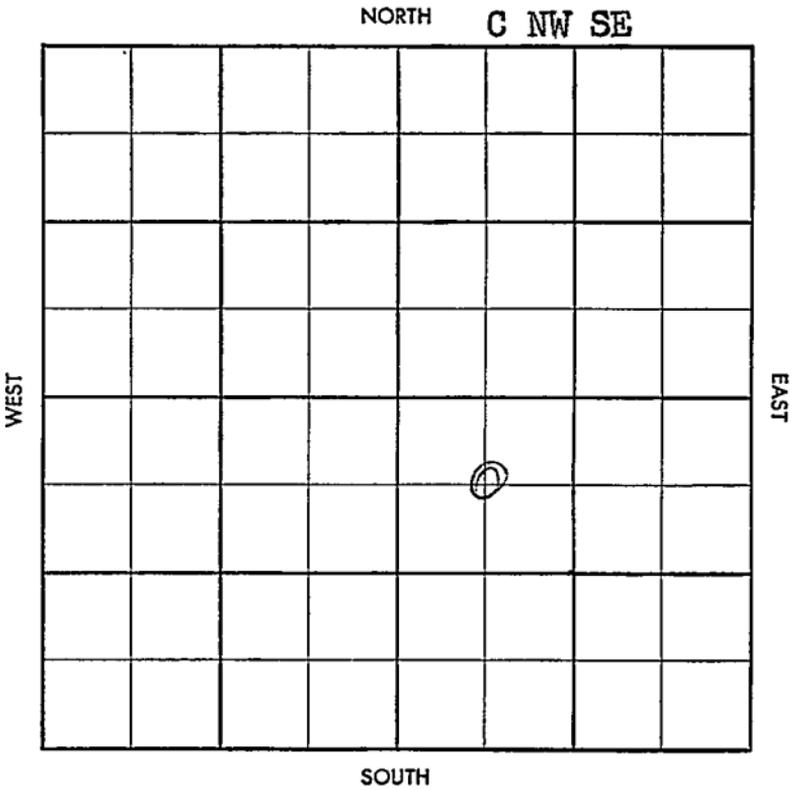

~~Top~~ ~~Foot~~ ~~Corham~~

Co. ~~C~~ Forat. ~~15~~

S-513-B

County Russell Elev. _____

Sec. 4 Twp. 14 Rge. 15W

Company G R A

Farm Name Witt "D" No. 1

TOPS	DEPTH	LOG	DATUM
Anh.	910		
Tp.			
H.			
Tr.			
Dg.			
B.L.			
L.			
K.C.			
B.K.C.			
Ce.			
C.			
M.			
M.			
K.			
Mz.			
Mq.			
V.			
S.			
S.			
A.			
R.			
Pf.			
G.			
T.D.			

Loc. in Sec. _____

C NW SE

Geol. _____

Contr. _____

Shields

Pool _____

Corham



Date Comm. 7-27-58

8" @ 916/500 drlg.

Co.

Lse.

No.

Sec.

T.

R.

Borham

Twp. _____ Pool _____
 Cr. _____ Facet _____

5-513B

County Russell Elev. 1475 DF. 1879 RB
 Sec. 14 Twp. 14 Rge. 15W
 Company CRA
 Farm Name Witt "D" (Red Hill) No. 1

FOPS	DEPTH	LOG	DATUM
Anth.	910		
TP <u>Diver</u>	<u>2459</u>		
H. <u>Tank lid</u>	<u>2465</u>		
IF <u>Li. tr</u>	<u>2502</u>		
Dg <u>Element</u>	<u>2556</u>		
B.L. <u>TP</u>	<u>2758</u>		
L. <u>Deer creek</u>	<u>2840</u>		
K. <u>Chick camp</u>	<u>2858</u>		
B.K.C. <u>H</u>	<u>2977</u>		
Ce. <u>T.R</u>	<u>2997</u>		
C. <u>Dg</u>	<u>3015</u>		
M. <u>L56</u>	<u>3030</u>		
M.			
K.			
Mz.			
Mq.			
V.			
IS.			
S.			
A.			
R.	<u>3271</u>		
PT.			
G.			
T.D.	<u>3273</u>		

Loc. in Sec. _____
C NW SE
 Geol. _____
 Contr. _____
Shields
 Pool _____
Gorham

COMPLETE

AUG 27 '58

Date Comm. 7-27-58
 8" @ 916/500 d rlg. Aug 6 '58 One 2446 -83
see 34' core 2530 AUG 13 '58
43 in 5 1/2 3271/200 west AUG 20
W. PD 3279. 350. 400A SLD + B
5 g. o. ph + 2 g. w. ph 4 hrs AUG 27 '58 SF
P 50 BO TR W 24 hr
DD 3280 SF 2x2
SW 2 BO PN 1E hr No W
P 71 BO 16 hr No W
P 50 BO TR W 24 hr