


Section 5 Township 14 Range 15W

Well Number #1 Dortland "C"

Company Stanolind

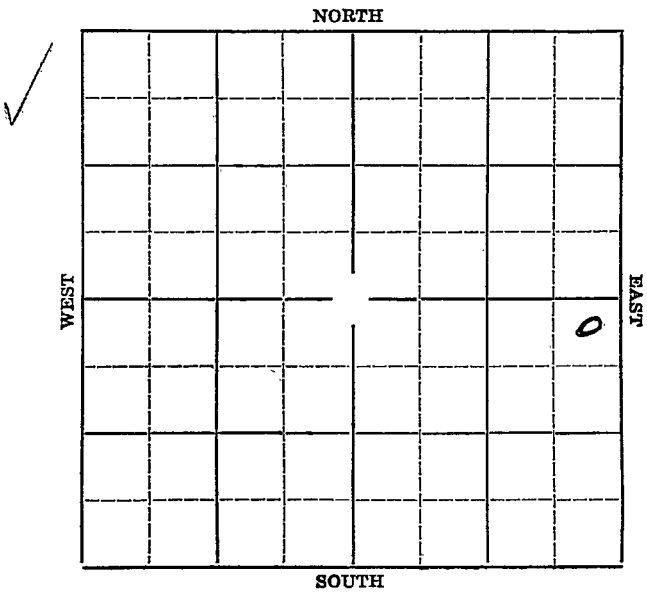

Sec. 5 Twp. 14 R. 15W

Well No. #1 Dorthand "C" Farm

Stanolind Company


330' Ft. from N. Line

_____ Ft. from S. Line

330' Ft. from E. Line

_____ Ft. from W. Line

Elev. 1891

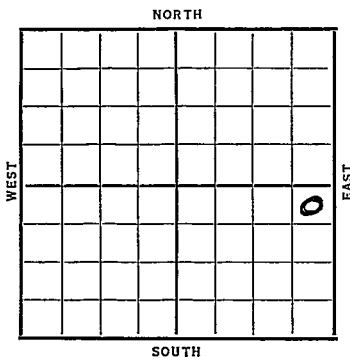

Date	REPORT
8/26	Location.
9/3	Rigging up.
9/10	--
9/18	15" @ 21'. 12" @ 471'. Drlg. 835'. 835'.
9/24	Anhydra te 918'. 10" @ 920'. Drlg. 1710'.
10/1	Drlg. 2490'.
10/8	8" @ 2510'. Drlg. 2515'.
10/15	Topeka 2670'-2675'. 1500' of oil. Under ream 8".
10/22	8" @ 2760'. WOC.
10/29	TD 2776'. 4000 gallons of acid. 2000' of oil.
11/6	Potential 641 in 19 hrs.
11/10	Topeka 2670 T. D. 2776 4000 Acid Pot. 1008
COMPLETED	

Map No. 72 Sec. 5 Twp. 14 R. 15WWell No. 1 "Northland C"Standard Company

Contractor

SECTION PLAT

			0

330 Ft. from N. Line

_____ Ft. from S. Line

330 Ft. from E. Line

_____ Ft. from W. Line

FIRST REPORT

Location ✓

Rig up _____

Drilling and Remarks:

RECORD

Cased _____ in., _____ ft.

Sand _____

Gas _____

Oil _____

Total Depth _____

PRODUCTION

1st 24 hrs. Nat. _____

1st 24 hrs. after shot _____

Gas _____ Cu. Ft.

Dry Hole _____

Abandoned _____

Date

AUG 26 1936₁₉

S. J. LEWIS

Scout

Press 80 KANSAS

Map No. 72 Sec. 5 Twp. 14 R. 15W

Well No. 1 Portland "C"

Standard Company

Contractor

SECTION PLAT

330 Ft. from N. Line

_____ Ft. from S. Line

330 Ft. from E. Line

_____ Ft. from W. Line

			0

COMPLETED

Location _____

Rig up _____

Drilling and Remarks:

Topeka 2670
4000 acid
P. J. 1008

RECORD

Cased _____ in., _____ ft.

Sand _____

Gas _____

Oil _____

Total Depth 2776

PRODUCTION

1st 24 hrs. Nat. _____

1st 24 hrs. after shot _____

Gas _____ Cu. Ft.

Dry Hole _____

Abandoned _____

Date

NOV 10 1936 19

S. J. LEWIS Scout