


Russell KANSAS

Section 5 Township 14 Range 15-W


Well No. 13 J. E. Baxter

Company Stanolind

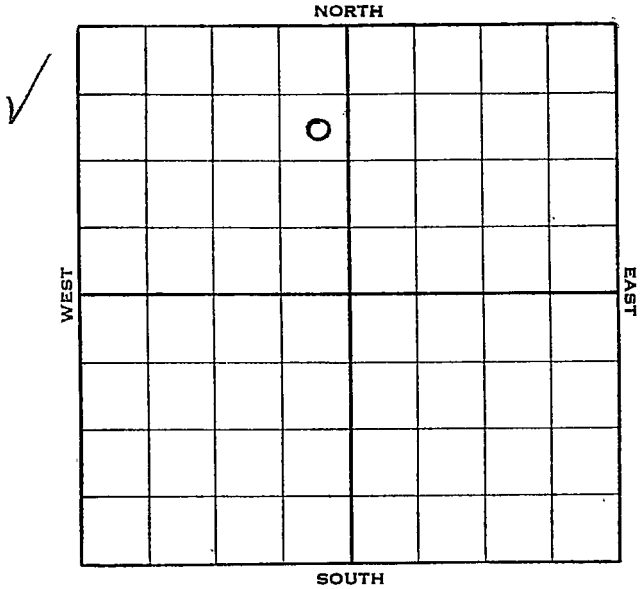

Sec. 5 Twp. 14 R. 15-WWell No. #13 J. E. Baxter FarmStanolind Company990 Ft. from N. Line Ft. from S. Line330 Ft. from E. Line Ft. from W. Line

Elev. 1893

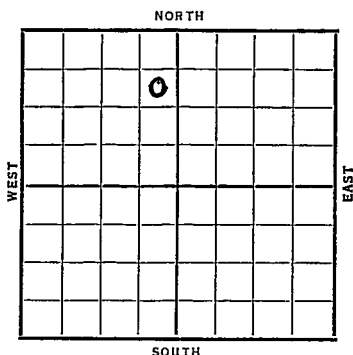

Date	REPORT
1938.	
3/9	Location
3/18	RUCT.
3/25	15" @ 41'.
	Dr1g. 429'.
4/1	12" @ 572'. Anhy 932'.
	10" @ 937'. Dr1g. 1255'.
4/8	Dr1g. 2330'.
4/15	8" @ 2519'. Dr1g. 2565'.
4/22	Topeka 2769'. 2769-73 1 B.W.
	2970-77'. 6" @ 2922'.
	Dr1g. 3010'.
4/29	K.C. 3041'. Pay 3068-72'.
	6" @ 3042'. Cleaning out.
5/4	6" @ 3042'.
	K.C. 3041'.
	T.D. 3072'.
	Potential 332 bbls.
	COMPLETED

Russell KANSAS

Map No. _____ Sec. 5 Twp. 14 R. 15W

Well No. 13 J E Baxter

Stanolind

Company

Contractor

FIRST REPORT

SECTION PLAT

	0		

SE NE NW

990 Ft. from N. Line

Ft. from S. Line

330 Ft. from E. Line

Ft. from W. Line

Location X

Rig up

Drilling and Remarks:

RECORD

Cased _____ in., _____ ft.

Sand _____

Gas _____

Oil _____

Total Depth _____

PRODUCTION

1st 24 hrs. Nat. _____

1st 24 hrs. after shot _____

Gas _____ Cu. Ft.

Dry Hole _____

Abandoned _____

Date

MAR 9 - 1938

19

H. D. Hatfield

Scout

Russell KANSAS

Map No. 72 Sec. 5 Twp. 14 R. 15WWell No. 13 J. E. BaxterStanolind

Company

Contractor

COMPLETED

SE NE NW

990 Ft. from N. Line Ft. from S. Line330 Ft. from E. Line Ft. from W. Line**SECTION PLAT**

	0		

Location Rig up

Drilling and Remarks:

POT 332**RECORD**Cased 6 in., 3042 ft.Sand KC 3041Gas Oil Total Depth 3072**PRODUCTION**1st 24 hrs. Nat. 1st 24 hrs. after shot Gas Cu. Ft.Dry Hole Abandoned

Date

MAY 4 - 1938 19 H. D. Hatfield Scout