


Russell

Map No. KANSAS Sec. 5 Twp. 14 R. 15 W

Well No. #1 J. A. Baxter Farm
Stanolind O & H. Company

330 Ft. from N. Line
____ Ft. from S. Line
330 Ft. from E. Line
____ Ft. from W. Line

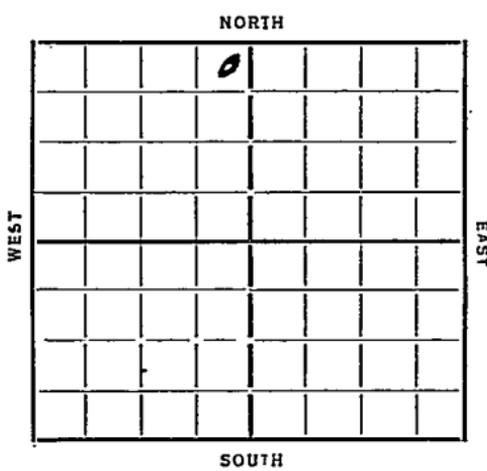

Date	REPORT
1935	
1/9	Location
1/17	1/24 — 1/31 — 2/7
2/14	2/21 — 2/28 — 3/7
3/14	3/21 — 3/28 — 4/4
4/11	4/18 — 4/26 — 5/2
5/9	Bldg
5/16	Rdg
5/23	5/29
6/6	Dlg 955 10" 934
6/13	" 1790
6/20	" 2570 8" 2510
6/28	2750 WR 8"
7/3	8" 2705
7/11	2782-92 8" 2778
	Dlg 2885
7/18	Ply 3058-62
	" 3070-75
	3094 T7 250' oil
	NC 3094 7" 3045
7/24	Bank 3058-94 T7 3094
	Pump 92 oil 60 water

COMPLETED

Map No. 77 Sec. 5 Twp. 14 R. 15W

Well No. 1- G. A. Bafter

Standard Oil & G. Company

Contractor

FIRST REPORTS

330 Ft. from N. Line

..... Ft. from S. Line

330 Ft. from E. Line

..... Ft. from W. Line

SECTION PLAT

	0		

Location

Rig up

Drilling and Remarks:

RECORD

Cased..... in., ft.

Sand.....

Gas.....

Oil.....

Total Depth.....

PRODUCTION

1st 24 hrs. Nat.....

1st 24 hrs. after shot.....

Gas..... Cu. Ft.

Dry Hole.....

Abandoned.....

Date

1-9-35 192

ORVAL MANNSCHRECK Scout

Map No. 72 Sec. 5 Twp. 14 R. 15W

Well No. 1. J. A. Baxter

Standard Company

Contractor

RECORDED

SECTION PLAT

330 Ft. from N. Line

..... Ft. from S. Line

330 Ft. from E. Line

..... Ft. from W. Line

	0		

Location.....

Rig up.....

Drilling and Remarks:

Pump 92 Oil
60 water

RECORD

Cased in., ft.

Sand 3058 - 94

Gas.....

Oil.....

Total Depth 3094

PRODUCTION

1st 24 hrs. Nat.....

1st 24 hrs. after shot.....

Gas..... Cu. Ft.

Dry Hole.....

Abandoned.....

Date

ORVAL MANNSCHRECK

7/24/35 192.....

Scout