Form 51-5M 5-37 Petrol


Russell

KANSAS

Section 5 Township 14 Range 15-W

Well No. 24 J. H. Dortland

Company Stanolind

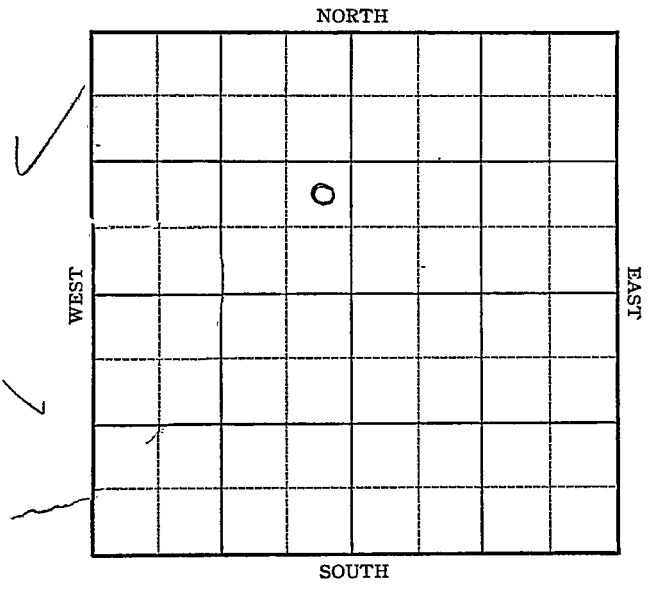


Form 252-A—5M—9-37 KANSAS Russell

Sec. 5 Twp. 14 - R. 15-W

Well No. #24 J. H. Dortland Farm

Stanolind Company

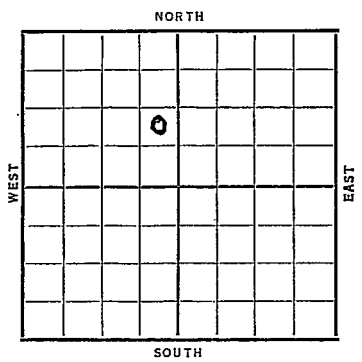

_____ Ft. from N. Line

990 Ft. from S. Line

330 Ft. from E. Line

_____ Ft. from W. Line

Elev. 1890'.

Date	REPORT
1938	
1/12	C. R.
1/20	15"-33' Drlg. 445'
1/28	Anhy 926' 10" - 935'
	Dlrg. 1450'
2/4	Drlg. 2385"
2/11	8" @ 2532'. Topeka 2766'.
	S.O. 2770'. Drlg. 2912'.
2/18	Oswald 3040'. 7" @ 3042'.
	Pay 3068-72' T.D. WOC.
2/26	" " " " "
3/2	7" @ 3042'.
	Oswald 3040'.
	T.D. 3072'.
	2000 acid.
	Potemtial 278 bbls.
	COMPLETED

Form 26—1M Bks.—2-29 Russell KANSAS

Map No. 72 Sec. 5 Twp. 14 R. 15W

Well No. 24 J. H. Dortland

Stanolind Company

Contractor

FIRST REPORT

NE SE NW


Ft. from N. Line

990 Ft. from S. Line

330 Ft. from E. Line

Ft. from W. Line

SECTION PLAT

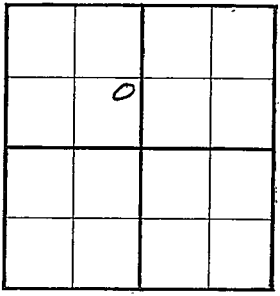

Location

Rig up

Drilling and Remarks:

CR

RECORD

Cased in., ft.

Sand

Gas

Oil

Total Depth

PRODUCTION

1st 24 hrs. Nat.

1st 24 hrs. after shot

Gas Cu. Ft.

Dry Hole

Abandoned

Date

JAN 12 1938 19

H. D. Hatfield Scout

Form 26—1M Bks.—2-29

Russell KANSAS

Map No. ____ Sec. 5 Twp. 14 R. 15W

Well No. 24 J. H. Dortland

Stanolind Company

Contractor

COMPLETED

NE SE NW


____ Ft. from N. Line

990 Ft. from S. Line

330 Ft. from E. Line

____ Ft. from W. Line

SECTION PLAT

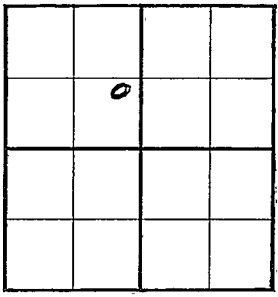

Location ____

Rig up ____

Drilling and Remarks:

7000 and

Pot 278

RECORD

Cased 7 in., 3042 ft.

Sand Oswald 3040

Gas ____

Oil ____

Total Depth 3072

PRODUCTION

1st 24 hrs. Nat. ____

1st 24 hrs. after shot ____

Gas ____ Cu. Ft.

Dry Hole ____

Abandoned ____

Date

MAR 2 - 1938 19

H. D. Hatfield Scout