


Section 5 Township 14 Range 15-W

Well Number 4 - J. H. Dortland "B"

Company Stanolind

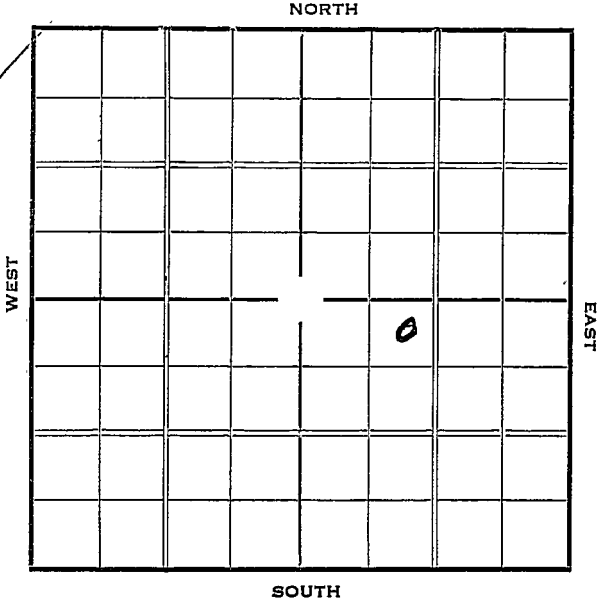

Sec. 5 Twp. 14 R. 15<sup>W</sup>

Well No. #4 J. H. Dortland "B" Farm

Stanolind Company


330 Ft. from N. Line

\_\_\_\_\_ Ft. from S. Line

\_\_\_\_\_ Ft. from E. Line

990 Ft. from W. Line

Elev. 1894

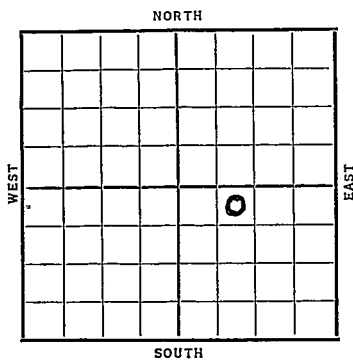

Date	REPORT
1937	
7/14	Location
7/23	Ponds.
7/30	Cable rig.
8/6	20" @ 29'. Drlg. 450'.
8/13	12" @ 462'. Anhy 921'.
	10" @ 930'. Drlg. 962'.
8/20	T.D. 1275'. SD for repairs.
8/28	Drlg. 1960'.
9/3	Drlg. 2560'.
9/10	8" @ 2668'. T.D. 2755' C.O.
9/17	8" @ 2742'. Drlg. 2804'.
9/24	7" @ 2820'. Drlg. 2960'.
10/2	K.C. 3040'. 7" @ 3042'.
	Coring 3049' no shows reported.
10/8	Pay 3069-71'. 400' oil.
10/15	T.D. 3080'. Testing.
	<b>OVER</b>

1937

10/20 7" @ 3042'.

K.C. 3040'.

T.D. 3080'.

Potential 415 bbls. Nat.

COMPLETED

Russell KANSAS

Map No. \_\_\_\_\_ Sec. 5 Twp. 14 R. 15Well No. 4-J. H. Portland "B"Stanlund Company

Contractor

## FIRST REPORT

## SECTION PLAT

		0	

330 Ft. from N. Line

\_\_\_\_\_ Ft. from S. Line

\_\_\_\_\_ Ft. from E. Line

990 Ft. from W. LineLocation 

Rig up \_\_\_\_\_

Drilling and Remarks: \_\_\_\_\_

## RECORD

Cased \_\_\_\_\_ in. \_\_\_\_\_ ft.

Sand \_\_\_\_\_

Gas \_\_\_\_\_

Oil \_\_\_\_\_

Total Depth \_\_\_\_\_

## PRODUCTION

1st 24 hrs. Nat. \_\_\_\_\_

1st 24 hrs. after shot \_\_\_\_\_

Gas \_\_\_\_\_ Cu. Ft.

Dry Hole \_\_\_\_\_

Abandoned \_\_\_\_\_

Date

JUL 14 1937 19H. D. Hatfield Scout

Russell **KANSAS**

Map No. \_\_\_\_\_ Sec. 5 Twp. 14 R. 15W

Well No. 4 J H Dortmund "B"

Stanolind Company

Contractor

**COMPLETED**

**SECTION PLAT**

330 **NE NW SE** Ft. from N. Line

\_\_\_\_\_ Ft. from S. Line

\_\_\_\_\_ Ft. from E. Line

990 Ft. from W. Line

		0	

Location \_\_\_\_\_

Rig up \_\_\_\_\_

Drilling and Remarks:

*POT-415*  
*NAT.*

**RECORD**

Cased 7 in., 3042 ft.

Sand NC 3040

Gas \_\_\_\_\_

Oil \_\_\_\_\_

Total Depth 3080

**PRODUCTION**

1st 24 hrs. Nat. \_\_\_\_\_

1st 24 hrs. after shot \_\_\_\_\_

Gas \_\_\_\_\_ Cu. Ft.

Dry Hole \_\_\_\_\_

Abandoned \_\_\_\_\_

Date

OCT 20 1937

H. D. Hatfield Scout