


Section 5 Township 14 Range 15-W

Well No. 13 - J. H. Dortland "C"

Company Stanolind

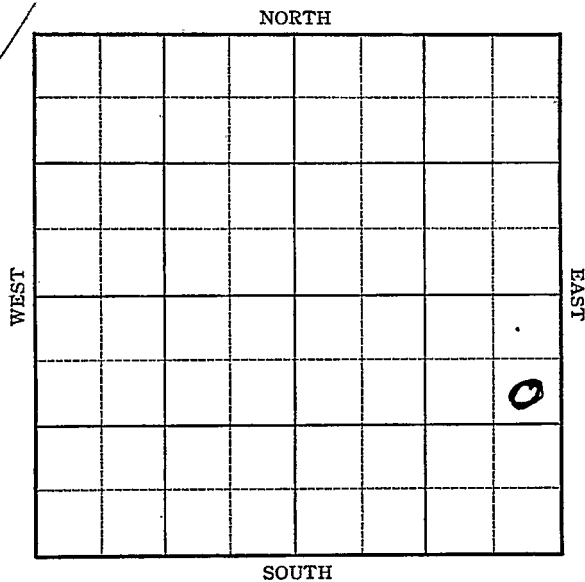

Sec. 5 Twp. 14 R. 15-W


Stanolind Company


990 Ft. from N. Line

_____ Ft. from S. Line

330 Ft. from E. Line

_____ Ft. from W. Line

Elev. 1890

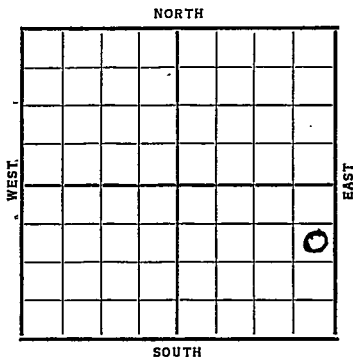

Date	REPORT
1937	
8/4	Material
8/13	B. Rig.
8/20	R. U.
8/28	15" @ 36'. 12" @ 560'. Drlg. 670'.
9/3	Anh@ 920'. 10" @ 923'. Dr .g. 1880'.
9/10	8" @ 2520'. T.D. 2610'. U.R.
9/17	8" @ 2727' T.D. C.O.
9/24	S.O. 2771'. K.C. 3038'. 7" @ 3040'. S.O. 3062'.
	Inc. 3062-65'. Drlg. 3067'.
10/2	T.D. 3077'. 3000 acid. Swb. 65 BOPH 2 hrs.
	OVER

1937

10/6 7" @ 3040'.

K.G. 3038'.

T.D. 3077'.

3000. acid.

Pot. 611 oil.

Est. 200 water. .

COMPLETED

KANSAS

Russell

Map No. _____ Sec. 5 Twp. 14 R. 15^w

Well No. 13-J.H. Portland "C"

Stanaland Company

Contractor

FIRST REPORT

990 Ft. from N. Line

_____ Ft. from S. Line

330 Ft. from E. Line

_____ Ft. from W. Line

SECTION PLAT

			0

Location _____

Rig up _____

Drilling and Remarks:

material

RECORD

Cased _____ in., _____ ft.

Sand _____

Gas _____

Oil _____

Total Depth _____

PRODUCTION

1st 24 hrs. Nat. _____

1st 24 hrs. after shot _____

Gas _____ Cu. Ft.

Dry Hole _____

Abandoned _____

Date

AUG 4 - 1937

H. D. Hatfield

Scout

Russell KANSAS

Map No. _____ Sec. 5 Twp. 14 R. 15W

Well No. 13 J H Dortland "C"

Stanolind

Company

Contractor

COMPLETED

SE NE SE

990 Ft. from N. Line

_____ Ft. from S. Line

330 Ft. from E. Line

_____ Ft. from W. Line

SECTION PLAT

			o

Location _____

Rig up _____

Drilling and Remarks:

3000 Acid

POT-611 oil

Est. 200 water

RECORD

Cased 7 in., 3040 ft.

Sand K.C. 3038

Gas _____

Oil _____

Total Depth 3077

PRODUCTION

1st 24 hrs. Nat. _____

1st 24 hrs. after shot _____

Gas _____ Cu. Ft.

Dry Hole _____

Abandoned _____

Date

OCT - 6 1937 19

I. D. Hatfield Scout