

KANSAS

Sec. 5 Twp. 14 R. 15W

Well No. #12 Portland "D" Farm

Stanolind Company

Gorham


990' Ft. from N. Line

_____ Ft. from S. Line

990' Ft. from E. Line

_____ Ft. from W. Line

SW NE SW

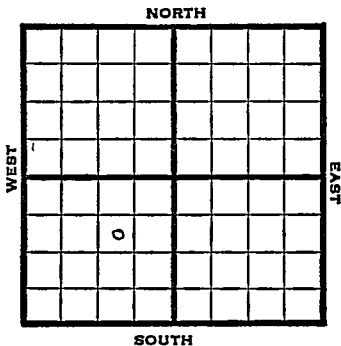

1948

Eli 1877' REPORT

7/14

13" @ 154'
Anhy. 920'
Drlg. 1602'

~~7/21~~

Tarkio 2518'
Topeka 2763'
Lansing 3042'
Drlg 3155'

7/28

Cong 3275'
Granite 3278'
TD 3280'
Aband.

ABANDONED

Map No. _____ Sec. 5 Twp. 14 R. 15W

Well No. 12 Dortland "D"

Stanolind Company

FIRST REPORT

Contractor

SW NE SW

SECTION PLAT

990 Ft. from N. Line

_____ Ft. from S. Line

990 Ft. from E. Line

_____ Ft. from W. Line

Russell County

Location _____

Rig up _____

Drilling and Remarks:

13" @ 154

anhy 920

Drlg. 1602

RECORD

Cased _____ in., _____ ft.

Sand _____

Gas _____

Oil _____

Total Depth _____

PRODUCTION

1st 24 hrs. Nat. _____

1st 24 hrs. after shot _____

Gas _____ Cu. Ft.

Dry Hole _____

Abandoned _____

Date

JUL 14 1948

19

S. J. LEWIS

Scout

