

Russell
 Form 51-5M-9-28-27423
 Map No. **KANSAS** Sec. 5 Twp. 14 R. 15^w
 Well No. 1- Mermis Farm
Mid West Company

NORTH

								0

WEST

EAST

SOUTH

Location.....
 Drilling Remarks

Rig Up.....
 Drilling Remarks

RECORD


Cased..... in..... ft.
 Sand.....
 Gas.....
 Oil.....
 Total Depth.....

PRODUCTION

1st 24 hrs. Nat.....
 1st 24 hrs. after shot.....
 Gas..... cu. ft.....
 Dry Hole.....
 Abandoned.....

Map No. **KANSAS** Sec. 5 Twp. 14 R. 15^w
Well No. 1- Mermis Farm
Mid West Company

330 Ft. from N. Line
..... Ft. from S. Line
330 Ft. from E. Line
..... Ft. from W. Line

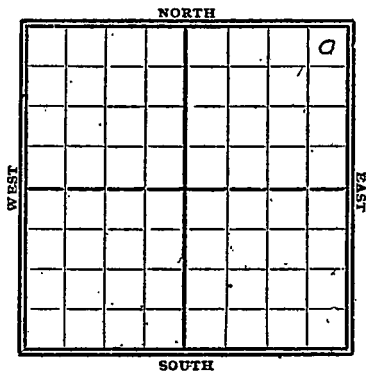

1928

Date	REPORT
11/14	ROG.
11/21	_____
11/28	_____
12/5	_____
12/12	_____
12/19	_____
12/26	Bldg Rig
1929	
1/2	Rig up
1/9	Spud
1/16	drlg 790'
1/23	" 1505'
1/30	" 2085'
2/6	fsy bailer 2515' T.D.
2/13	_____
2/20	drlg 2650' 8"-2520
2/27	" 2840'
3/6	fsy 6" pipe - 3065'-T.D.
3/13	run 4 3/4" csg - 3065'
3/20	Top Oswald sd 3065' T.D. 3073'
	swabbing 60 bbl. 24 hrs.

MAP NO. KANSAS SEC. 5 TWP. 14 R. 15W

WELL NO. 1 Permian

Mid West COMPANY

CONTRACTOR

SECTION PLAT

			0

330 FT. FROM N. LINE

FT. FROM S. LINE

330 FT. FROM E. LINE

FT. FROM W. LINE

FIRST REPORTS

LOCATION _____

RIG UP _____

DRILLING AND REMARKS:

ROG

RECORD

CASED _____ IN. _____ FT.

SAND _____

GAS _____

OIL _____

TOTAL DEPTH _____

PRODUCTION

1ST 24 HRS. NAT. _____

1ST 24 HRS. AFTER SHOT _____

GAS _____ CU. FT.

DRY HOLE _____

ABANDONED _____

DATE

NOV 14 1928

S. J. LEWIS

SCOUT

MAP No. KANSAS SEC. 5 TWP. 14 R. 15W

WELL No. Y Hermis

Phil Vest COMPANY

CONTRACTOR

SECTION PLAT

			0

330 FT. FROM N. LINE

FT. FROM S. LINE

330 FT. FROM E. LINE

FT. FROM W. LINE

COMPLETED

LOCATION _____

RIG UP _____

DRILLING AND REMARKS:

Top Oswald Sand
3065

Swabbing 6088 ft
24 hrs

RECORD

CASED _____ IN. _____ FT.

SAND _____

GAS _____

OIL _____

TOTAL DEPTH 3073

PRODUCTION

1ST 24 HRS. NAT. _____

1ST 24 HRS. AFTER SHOT _____

GAS _____ CU. FT.

DRY-HOLE _____

ABANDONED _____

DATE

MAR 20 1929 192

S. J. LEWIS SCOUT