



**KANSAS**

Map No. \_\_\_\_\_ Sec. 5 Twp. 14 R. 15W

Well No. 4-Morris Farm \_\_\_\_\_


Mid West Company

330 Ft. from N. Line

\_\_\_\_\_ Ft. from S. Line

\_\_\_\_\_ Ft. from E. Line

990 Ft. from W. Line

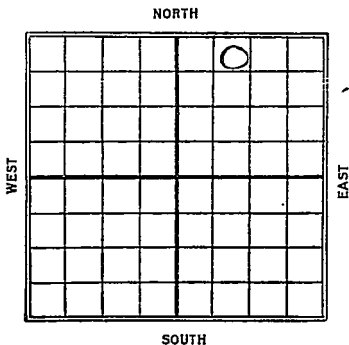

1928

Date

REPORT

Date	REPORT
1/18	Cellar
1/25	Bldg rig
1/31	Rigging up-
2/15	Drlg 840-
2/22	" 1015
2/29	" 1185
3/7	" 2525
3/14	" 2900
3/21	Oswald sand
	30.61-3108
	125 bbl pumper

*Russell*  
*Oil Inc.*

Map No. **KANSAS** Sec. 5 Twp. 14 R. 15 N

Well No. 4 Dennis

Oil West Company

Contractor

SECTION PLAT

		0	

230 Ft. from N. Line

\_\_\_\_\_ Ft. from S. Line

\_\_\_\_\_ Ft. from E. Line

990 Ft. from W. Line

FIRST REPORTS

Location \_\_\_\_\_

Rig up \_\_\_\_\_

Drilling and Remarks:

*cellar*

RECORD

Cased \_\_\_\_\_ in., \_\_\_\_\_ ft.

Sand \_\_\_\_\_

Gas \_\_\_\_\_

Oil \_\_\_\_\_

Total Depth \_\_\_\_\_

PRODUCTION

1st 24 hrs. Nat. \_\_\_\_\_

1st 24 hrs. after shot \_\_\_\_\_

Gas \_\_\_\_\_ Cu. Ft.

Dry Hole \_\_\_\_\_

Abandoned \_\_\_\_\_

Date

JAN 18 1922

S. J. LEWIS Scout

*Rede 16*  
*no tracing*  
**KANSAS**

Map No. \_\_\_\_\_ Sec. 5 Twp. 14 R. 15W

Well No. 4 Mermis

Mial West Company

Contractor

**SECTION PLAT**

330 Ft. from N. Line

\_\_\_\_\_ Ft. from S. Line

\_\_\_\_\_ Ft. from E. Line

990 Ft. from W. Line

		0	

**COMPLETED**

Location \_\_\_\_\_

Rig up \_\_\_\_\_

Drilling and Remarks:

*Oswald Sand*

*3061-3108*

*125 ft. pump etc.*

**RECORD**

Cased \_\_\_\_\_ in., \_\_\_\_\_ ft.

Sand \_\_\_\_\_

Gas \_\_\_\_\_

Oil \_\_\_\_\_

Total Depth \_\_\_\_\_

**PRODUCTION**

1st 24 hrs. Nat. \_\_\_\_\_

1st 24 hrs. after shot \_\_\_\_\_

Gas \_\_\_\_\_ Cu

Dry Hole \_\_\_\_\_

Abandoned \_\_\_\_\_

Date

**MAR 21 1928**

**S. J. LEWIS**

192

*Russell*

MAP NO. KANSAS SEC. 5 TWP. 14S R. 15W

WELL NO. 4 Merriam

*Medanek*

COMPANY

CONTRACTOR

*no well map COMPLETED*

SECTION PLAT

		0	

\_\_\_\_\_ FT. FROM N. LINE

\_\_\_\_\_ FT. FROM S. LINE

\_\_\_\_\_ FT. FROM E. LINE

\_\_\_\_\_ FT. FROM W. LINE

RECORD

LOCATION \_\_\_\_\_

CASED \_\_\_\_\_ IN. \_\_\_\_\_ FT.

RIG UP \_\_\_\_\_

SAND \_\_\_\_\_

DRILLING AND REMARKS:

GAS \_\_\_\_\_

*30617 overhaul  
3108  
125 lbs.  
38 lbs.*

OIL

TOTAL DEPTH 3108

PRODUCTION

1ST 24 HRS. NAT. \_\_\_\_\_

1ST 24 HRS. AFTER SHOT \_\_\_\_\_

GAS \_\_\_\_\_ CU. FT.

DRY HOLE \_\_\_\_\_

ABANDONED \_\_\_\_\_

DATE

*3/21 8*