


Section 5 Township 14 Range 15-W

Well No. 13- C. A. Mermis

Company Stanolind

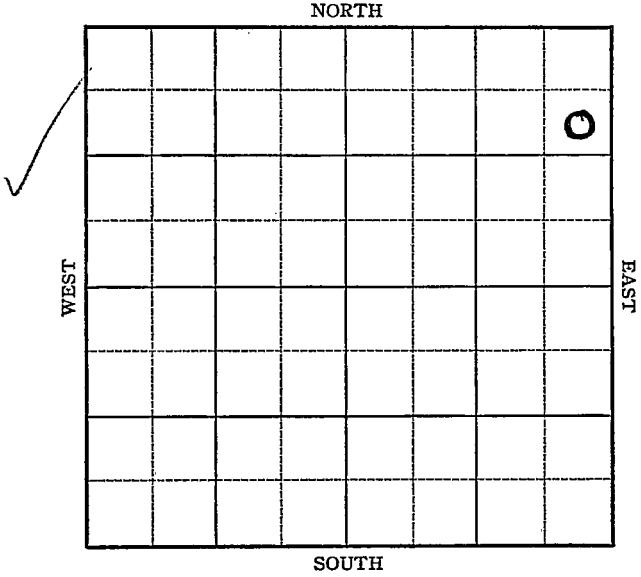

Sec. 5 " Twp. -14 R. 15-W

Well No. #13 C. A. Mermis Farm
Stanolind Company


990 Ft. from N. Line

_____ Ft. from S. Line

330 Ft. from E. Line

_____ Ft. from W. Line

Elev. 1900

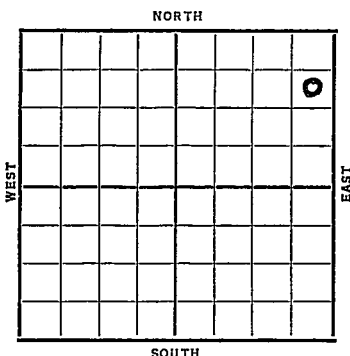

Date	REPORT
1937	
9/8	Location
9/17	B. C. R.
9/24	Spud.
10/2	15" @ 36'. 12" @ 550'.
	Drlg. 900'.
10/8	Anhy 936'. 10" @ 939'.
	Drlg. 1705'.
10/15	T.D. 2525' & 8". C.O.
10/22	Topeka 2769'. S.S.O.
	Drlg. 2960'.
10/29	K.C. 3047'. 7" @ 3052'.
	Pay 3079-81'. T.D. 3083'.
	100' oil $\frac{1}{2}$ hr.
11/3	7" @ 3052'.
	K.C. 3047'.
	T.D. 3106'.
	3000 acid.
	Potential 20.6 bbls.
	COMPLETED

Russell **KANSAS**Map No. _____ Sec. 5 Twp. 14 R. 15WWell No. 13 C A MermisStanolind

Company

Contractor

COMPLETED**SE NE NE**990 Ft. from N. Line

_____ Ft. from S. Line

330 Ft. from E. Line

_____ Ft. from W. Line

SECTION PLAT

			o

Location _____

Rig up _____

Drilling and Remarks:

3000 Acid.POT-206**RECORD**Cased 7 in., 3052 ft.Sand K.C. 3047

Gas _____

Oil _____

Total Depth 3106**PRODUCTION**

1st 24 hrs. Nat. _____

1st 24 hrs. after shot _____

Gas _____ Cu. Ft.

Dry Hole _____

Abandoned _____

Date

NOV 3 1937 19H. D. Hatfield Scout

Map No. _____ Sec. 5 Twp. 14 R. 15^W

Well No. 13-C. A. Mermis

Stanolind Company

Contractor

FIRST REPORT

SECTION PLAT

990 Ft. from N. Line

_____ Ft. from S. Line

330 Ft. from E. Line

_____ Ft. from W. Line

			6

Location

Rig up _____

Drilling and Remarks:

RECORD

Cased _____ in., _____ ft.

Sand _____

Gas _____

Oil _____

Total Depth _____

PRODUCTION

1st 24 hrs. Nat. _____

1st 24 hrs. after shot _____

Gas _____ Cu. Ft.

Dry Hole _____

Abandoned _____

Date

SEP 8 1907 19

H. D. Hatfield

Scout