


Section 5 Township 14 Range 15-W

Well No. 16 - C. A. Mermis

Company Stanolind

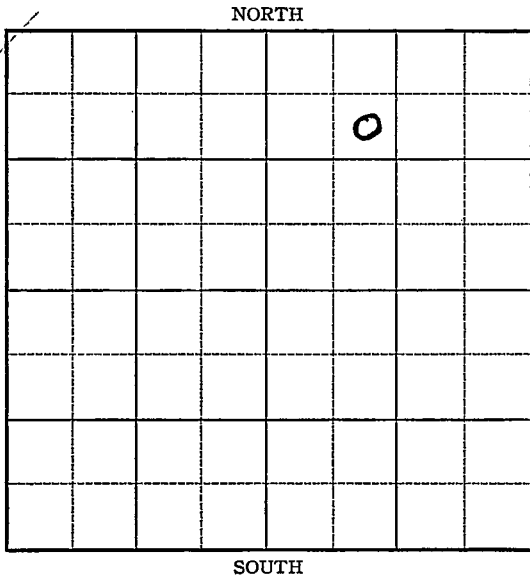

Sec. 5 Twp. 14 R. 15-W

Well No. #16 C. A. Mermis Farm  
Stanolind Company


           Ft. from N. Line

990 Ft. from S. Line

990 Ft. from E. Line

           Ft. from W. Line

Elev. 1900

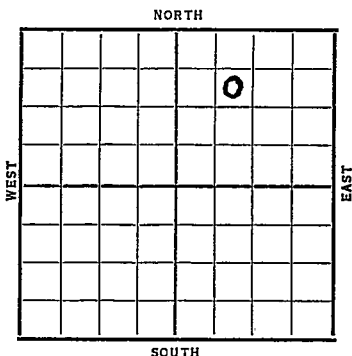

Date	REPORT
<b>1937</b>	
9/8	Location
9/17	B. C. R.
9/24	15" @ 38' Spud.
10/2	12" @ 572'. Drlg. 705'.
10/8	Anhy 935'. 10" @ 936'.
	Drlg. 1395'.
10/15	Drlg. 2300'.
10/22	Topeka 2768' S.S.O.
	Drlg. 2926'.
10/29	K.C. 3053'. Pay 3081-84'.
	200' oil 3 hrs. 7" @ 3056'. WOC
11/3	7" @ 3056'.
	K.C. 3053'.
	T.D. 3110'.
	3000 acid.
	Potential 222 bbls.
	<b>COMPLETED</b>

Map No. \_\_\_\_\_ Sec. 5 Twp. 14 R. 15<sup>W</sup>

Well No. 16-C. G. Mermis

Stanford Company

Contractor

FIRST REPORT

SECTION PLAT

\_\_\_\_\_ Ft. from N. Line

990 Ft. from S. Line

990 Ft. from E. Line

\_\_\_\_\_ Ft. from W. Line

		o	

Location

Rig up \_\_\_\_\_

Drilling and Remarks:

RECORD

Cased \_\_\_\_\_ in., \_\_\_\_\_ ft.

Sand \_\_\_\_\_

Gas \_\_\_\_\_

Oil \_\_\_\_\_

Total Depth \_\_\_\_\_

PRODUCTION

1st 24 hrs. Nat. \_\_\_\_\_

1st 24 hrs. after shot \_\_\_\_\_

Gas \_\_\_\_\_ Cu. Ft.

Dry Hole \_\_\_\_\_

Abandoned \_\_\_\_\_

Date

SEP 8 1937

E. D. Hatfield

19

Scout

Russell **KANSAS**

Map No. \_\_\_\_\_ Sec. **5** Twp. **14** **R15W**

Well No. **16 C A Mermis**

**Stanolind**

Company

Contractor

**COMPLETED**

**SE NW NE**

\_\_\_\_\_ Ft. from N. Line

**990** Ft. from S. Line

**990** Ft. from E. Line

\_\_\_\_\_ Ft. from W. Line

**SECTION PLAT**

		0	

Location \_\_\_\_\_

Rig up \_\_\_\_\_

Drilling and Remarks:

*3000 Acid*

*POT - 222*

**RECORD**

Cased 7 in., 3056 ft.

Sand *K.C.* 3053

Gas \_\_\_\_\_

Oil \_\_\_\_\_

Total Depth 3110

**PRODUCTION**

1st 24 hrs. Nat. \_\_\_\_\_

1st 24 hrs. after shot \_\_\_\_\_

Gas \_\_\_\_\_ Cu. Ft.

Dry Hole \_\_\_\_\_

Abandoned \_\_\_\_\_

Date

**NOV 3 1937**

**H. D. Hatfield**

Score