

KANSAS


Russell

Form 51-5M 5-37 Petrol

Section 5 Township 14 Range 15-W

Well No. #19 C.A. Mermis

Company Stanolind

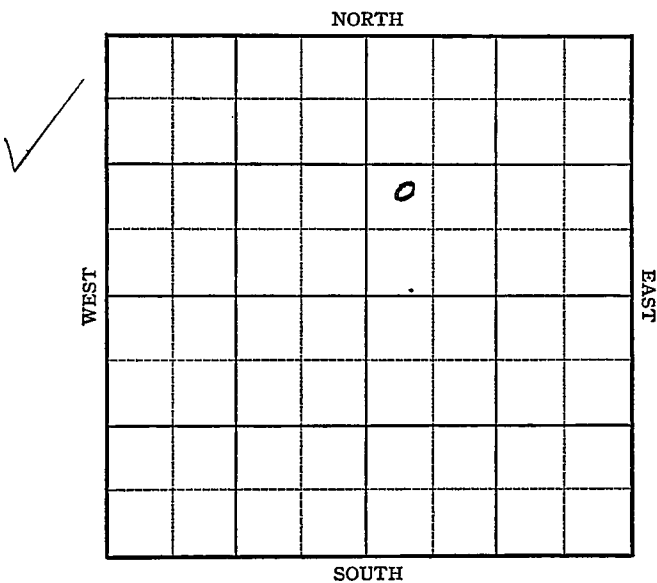

Sec. 5 Twp. 14 R. 15-W

Well No. #19 C. A. Mermis Farm
Starolind Company


 Ft. from N. Line

990 Ft. from S. Line

 Ft. from E. Line

330 Ft. from W. Line

Elev. 1895

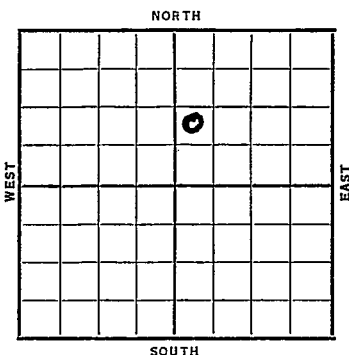

Date	REPORT
1937	
10/20	Cellar.
10/29	"
11/5	"
11/12	Cable rig.
11/19	16" @ 40'. Drlg. 435'.
11/26	13" @ 571'. 10" @ 936'.
	Drlg. 1258'.
12/3	Anhy 929'. Drlg. 2390'.
12/10	S.O. 2363-68'. 8" @ 2523'.
	Lopeka 2763'. Drlg. 2960'.
	No shows.
12/17	K.C. 4030'. S.O. 3067-72'.
	T.D. 3076'. 450' fluid.
	P.B. 3071'. 7" @ 3043'. WOG.
12/24	" " " " "
12/31	" " " " "
	" " " " "
	OVER

1938

1/5

7" @ 3043'.

K.C. 3040'.

T.D. 3076'.

P.B. 3071'.

1000 acid.

Potential 437 bbls.

COMPLETED

Russell **KANSAS**Map No. _____ Sec. 5 Twp. 14 R. 15WWell No. 19 C. A. MermisStanolind Company

Contractor

FIRST REPORT

NW SW NE

_____ Ft. from N. Line

990 Ft. from S. Line

_____ Ft. from E. Line

330 Ft. from W. Line**SECTION PLAT**

		o	

Location _____

Rig up _____

Drilling and Remarks:

Cellar

RECORD

Cased _____ in., _____ ft.

Sand _____

Gas _____

Oil _____

Total Depth _____

PRODUCTION

1st 24 hrs. Nat. _____

1st 24 hrs. after shot _____

Gas _____ Cu. Ft.

Dry Hole _____

Abandoned _____

Date

Oct 20 1927 19H. D. Hatfield Scout

Map No. 72 Sec. 5 Twp. 14 R. 15W

Well No. 19 G. A. Mermis

Stanolind Company

Contractor

COMPLETED

SECTION PLAT

 NW SW NE
 Ft. from N. Line
990 Ft. from S. Line
 Ft. from E. Line
330 Ft. from W. Line

		0	

Location

Rig up

Drilling and Remarks:

P.B. 3071
1000 Acid
POT-437

RECORD

Cased 7 in., 3043 ft.
 Sand KC 3040
 Gas
 Oil
 Total Depth 3076

PRODUCTION

1st 24 hrs. Nat.
 1st 24 hrs. after shot
 Gas Cu. Ft.
 Dry Hole
 Abandoned

Date

JAN 5 - 1938 19 H. D. Hatfield Scout