


Section 5 Township 14 Range 15-W

Well No. 22 - C. A. Wermis

Company Stanolind

NORTH

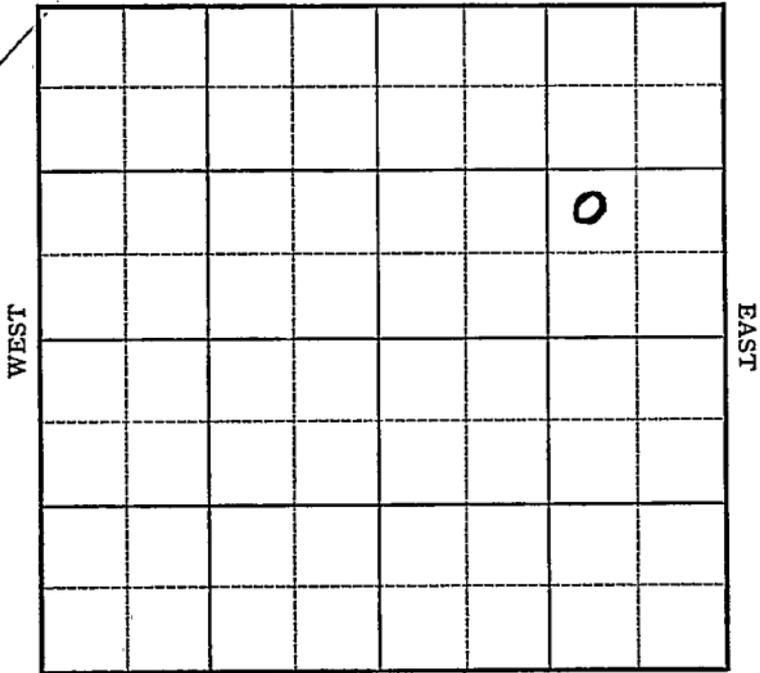

SOUTH

[Handwritten mark]


Sec. 5 Twp. 14 R. 15-WWell No. #22 C. A. Mermis FarmStanolind Company990 Ft. from N. Line

_____ Ft. from S. Line

_____ Ft. from E. Line

990 Ft. from W. Line

Elev. 1898

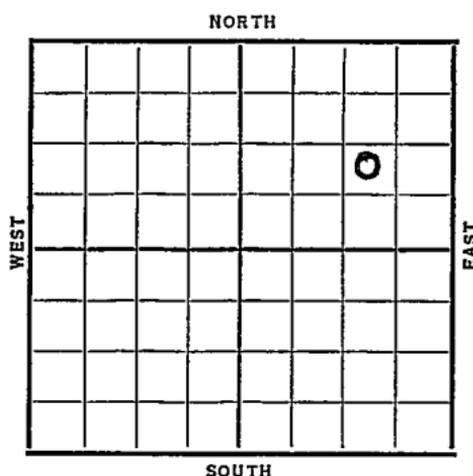

Date	REPORT
1937	
9/8	Location
9/17	B. C. R.
9/24	R. up.
10/2	15" @ 36'. 12" @ 572'. Drlg. 575'.
10/8	T.D. 1065' SD.
10/15	10" @ 926'. Drlg. 2310'.
10/22	8" @ 2650'. Drlg. 2765'.
10/29	K.C. 3040'. Pay 3058-60' T.D. Swab 4 bbls. oil P.H. 7" @ 3042'. WOC.
11/5	T.D. 3086'. 3000 acid.
11/10	7" @ 3042'. K.C. 3040'. Pay 3058-60'. T.D. 3086'. 3000 acid. Potential 786 oil & 48 water.
	COMPLETED

Map No. _____ Sec. 5 Twp. 14 R. 15^W

Well No. 22 - C. A. Mermis

Stanolind Company

Contractor

FIRST REPORT

SECTION PLAT

990 Ft. from N. Line

_____ Ft. from S. Line

_____ Ft. from E. Line

990 Ft. from W. Line

			0

Location

Rig up _____

Drilling and Remarks:

RECORD

Cased _____ in., _____ ft.

Sand _____

Gas _____

Oil _____

Total Depth _____

PRODUCTION

1st 24 hrs. Nat. _____

1st 24 hrs. after shot _____

Gas _____ Cu. Ft.

Dry Hole _____

Abandoned _____

Date

SEP 8 1937

H. D. Hatfield Scout

Russell KANSAS

Map No. _____ Sec. 5 Twp. 14 R. 15W

Well No. 22 C.A. Mermis

Stanolind Company

Contractor

COMPLETED

NW SE NE

990 Ft. from N. Line

_____ Ft. from S. Line

_____ Ft. from E. Line

990 Ft. from W. Line

SECTION PLAT

			0

Location _____

Rig up _____

Drilling and Remarks:

3000 acid

*POT - 786 oil
48 water*

RECORD

Cased 7 in., 3042 ft.

Sand K.C. 3040

Gas Pay 3058-60

Oil _____

Total Depth 3086

PRODUCTION

1st 24 hrs. Nat. _____

1st 24 hrs. after shot _____

Gas _____ Cu. Ft.

Dry Hole _____

Abandoned _____

Date

NOV 10 1937 19

H. D. Hatfield Scout